


Map No. Kan Sec. 21 Twp. 33 R. 3E

Well No. 3 St Snyder Farm
Waite-Phillips Company

NORTH

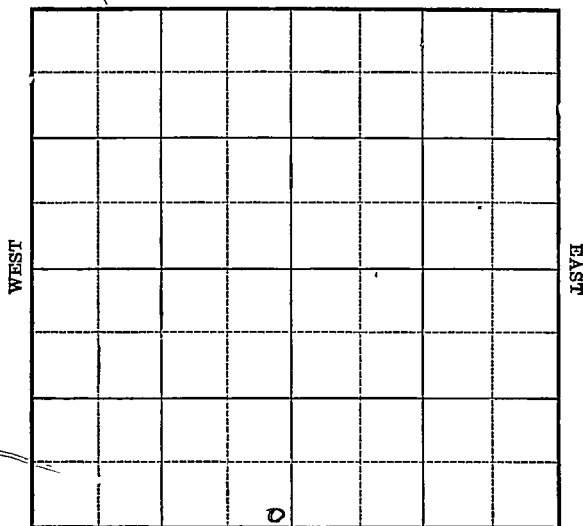

SOUTH

Location _____

Drilling Remarks

RECORD

Cased _____ in. _____ ft.

Sand _____

Gas _____

Oil _____

Total Depth _____

Rig Up _____

Drilling Remarks

PRODUCTION

1st 24 hrs. Nat. _____

1st. 24 hrs. after shot _____

Gas _____ cu. ft.

Dry Hole _____

Abandoned _____

Map No. Kan Sec. 21 Twp. 33 R. 3^E

Well No. 3 St Snyder Farm
Waite Phillips Company


..... Ft. from N. Line

320 Ft. from S. Line

330 Ft. from E. Line

..... Ft. from W. Line

B

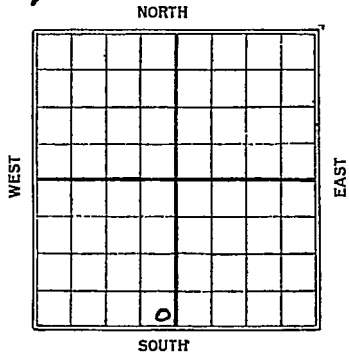

Date	REPORT
7/22	Location
7/29	15 1/2 @ 446 Pkg. 760'
8/5	1575
8/14	2250
8/19	2425
8/26	2865
9/9	3244 Oil 3252
	Btm Sand + T.D. 3284
	538 Bbls nat 12 hours

Map No. **KANSAS** Sec. 21 Twp. 33 R. 3E

Well No. 3 W Snyder

Watts Phillips Company

Contractor

FIRST REPORT

SECTION PLAT

----- Ft. from N. Line

330' Ft. from S. Line

330' Ft. from E. Line

----- Ft. from W. Line

Location ✓✓

Rig up -----

Drilling and Remarks:

RECORD

Cased ----- in., ----- ft.

Sand -----

Gas -----

Oil -----

Total Depth -----

PRODUCTION

1st 24 hrs. Nat. -----

1st 24 hrs. after shot -----

Gas ----- Cu. Ft.

Dry Hole -----

Abandoned -----

Date

JUL 22 1925

M. A. BENEAR

----- 1925 ----- Scout


Well No. 3 H. S. S. S.

Waite Phillips Company

Contractor

SECTION PLAT

----- Ft. from N. Line

330 Ft. from S. Line

330 Ft. from E. Line

----- Ft. from W. Line

COMPLETED

Location -----

Rig up -----

Drilling and Remarks:

NS 3244
DL 3252
BS & T. J. 3284
538 H. N. 8. 12 hrs

RECORD

Cased ----- in., ----- ft.

Sand -----

Gas -----

Oil -----

Total Depth -----

PRODUCTION

1st 24 hrs. Nat. -----

1st 24 hrs. after shot -----

Gas ----- Cu. Ft.

Dry Hole -----

Abandoned -----

Date

SEP 9 1925

S. J. LEWIS

Scout