


KANSAS

Map No. _____ Sec. 21 Twp. 33 R. 3

Well No. 4 W Snyder Farm

W Phillips Company

NORTH

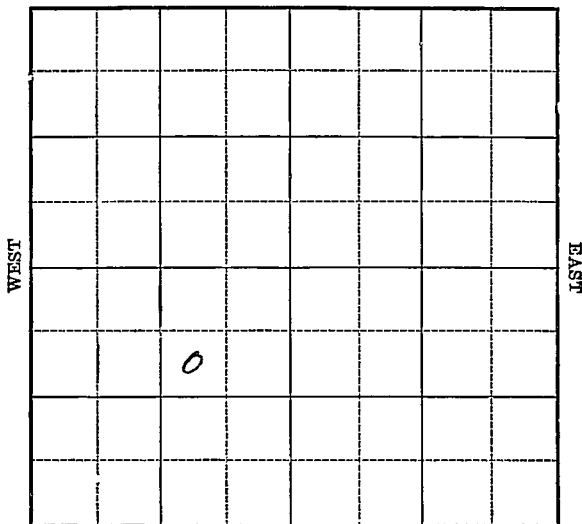

Location _____

Drilling Remarks _____

Rig Up _____

Drilling Remarks _____

RECORD

Cased _____ in. _____ ft.

Sand _____

Gas _____

Oil _____

Total Depth _____

PRODUCTION

1st 24 hrs. Nat. _____

1st. 24 hrs. after shot _____

Gas _____ cu. ft.

Dry Hole _____

Abandoned _____

Map No. KANSAS Sec. 21 Twp. 33 R. 3E

Well No. H. Snyder

H. Phillips & Co. Company

Contractor

FIRST REPORT

940 Ft. from N. Line

_____ Ft. from S. Line

994 Ft. from E. Line

_____ Ft. from W. Line

SECTION PLAT

	0		

Location ✓

Rig up _____

Drilling and Remarks:

RECORD

Cased _____ in., _____ ft.

Sand _____

Gas _____

Oil _____

Total Depth _____

PRODUCTION

1st 24 hrs. Nat. _____

1st 24 hrs. after shot _____

Gas _____ Cu. Ft.

Dry Hole _____

Abandoned _____

Date

AUG 12 1925

S. J. LEWIS

Scout

K1

Map No. KANSAS Sec. 21 Twp. 23 R. 2E

Well No. 4 Wm Snyder

Waite Phillips Company

Contractor

SECTION PLAT

940 Ft. from N. Line

_____ Ft. from S. Line

994 Ft. from E. Line

_____ Ft. from W. Line

	0		

COMPLETED

Location _____

Rig up _____

Drilling and Remarks:

TB 3240
Oil & Gas 3203
BB 3271
TJ 3273

250 8/6

RECORD

Cased _____ in., _____ ft.

Sand _____

Gas _____

Oil _____

Total Depth _____

PRODUCTION

1st 24 hrs. Nat. _____

1st 24 hrs. after shot _____

Gas _____ Cu. Ft.

Dry Hole _____

Abandoned _____

Date

OCT 28 1925

S. J. LEWIS

_____ 192_____

_____ Scout