

720


Cowley, County
Sec. 35 Twp 32 R 4

E. E. WILSON NO. 1.

SE 1/4 of NW 1/4 of 35-32-4.
Cowley County, Kansas.

Cowley Oil Company.

Contractor-Sam Swartz.

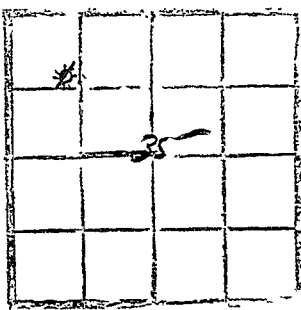

LOG.			
	Red		
Soil		30	30
Gravel		5	35
Lime	White	35	70
Red Rock	Red	10	80
Lime	White	10	90
Shale	White	30	100
Lime	White	5	105
Red Rock	red	10	115
Lime	White	50	165
Shale	White	5	170
Shale	Black	15	185
Lime	White	10	205
Shale	Blue	15	220
Lime	White	16	236
Shale	White	10	246
Red Rock	Red	5	251
Lime	White	20	271
Shale	Blue	9	280
Lime	White	15	295
Red Rock	Red	35	330
Shale	Blue	10	340
Red Rock	Red	10	350
Shale	White	10	360
Lime	White	40	400
Shale	Blue	5	405
Lime	White	5	410
Shale	White	10	420
Lime	White	10	430
Shale	Blue	15	445
Lime	White	40	485
Shale	Blue	6	491
Lime	White	10	501
Shale	Blue	5	506
Lime	White	10	516
Shale	Blue	4	520
Lime	White	10	530
Shale	White	30	560
Lime	White	15	575
Shale	Blue	12	587
sand Gas		8	595
sandy shale		14	609
sand Gas		8	617

Total Depth.

CASING RECORD.

12 1/2"40 feet.
10"430 feet.