


Section 26 Township 12 Range 16W

Well No. #4 Sitz

Company Kewanee Oil

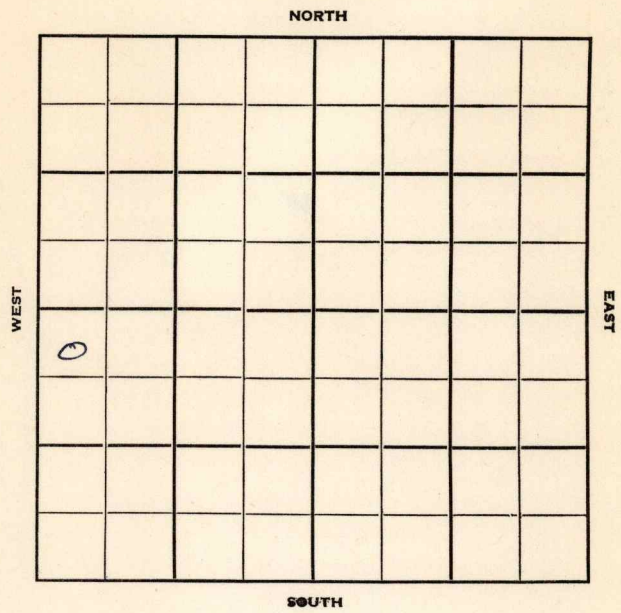

Ellis

KANSAS

Sec. 26 Twp. 12 R. ✓ 16W

Well No. #1 Sitz Farm

Kewanee Oil Company

Gross Contractor


330 Ft. from N. Line

_____ Ft. from S. Line

_____ Ft. from E. Line

330 Ft. from W. Line

NW NW SW

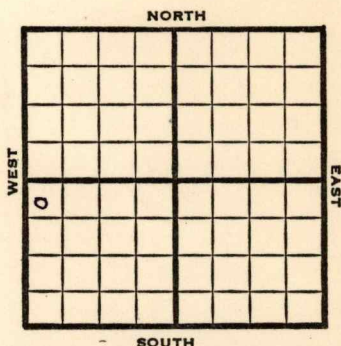

1952 Elev. 2058' REPORT

3/26 Spud 3-24-52
Surf. set

4/1 8" @ 240'
Anhy 1199'
Drlg. 2260'

4/9 Heeb 3203 Dodge 3224
Lans. 3251 Arb. 3518
RTD 3523
7" @ 3521

4/23 Spud 3-24-52
Oil Well TD 3523 8" @ 240
Anhy 1199 Heeb. 3203
Dodge 3224 Lans. 3251
Arb. 3518
TD 3523 7" @ 3521 CO to 3523
S/ 34 boph 5 hr.
Comp. 268 bopd

COMPLETED

County Ellis State KansasSec. 26 (Blk. 12 (Sur. 16W Map No.Operator Kewanee OilWell No. 4 Farm SitzElev. 2058 Location NW NW SW330 Ft. From N Line SW330 Ft. From W Line Quarter

1st. Report

Completion APR 23 1952

Remarks

Gross - Contr.Spudding Date 3-24-52Drlg. Data Oil well TD 35238" @ 240 Anhy 1199 Heeb. 3203Dodge 3224 Lans. 3251 Arb. 3518TD 3523 7" @ 3521 CO to 3523S/ 34 boph 5 hr. Comp. 268 bopd

J. G. McGEHEE