

Ellis

KANSAS

SECTION 26 TOWNSHIP 12 RANGE 16 W

WELL NO. #5 Stiz "B"

COMPANY Kewanee Oil

NORTH

0							

WEST

EAST

SOUTH

Ellis

KANSAS

SEC. 26	TWP. 12	R. 16W
------------	------------	-----------

WELL NO.

#5 Sitz "B"

FARM

COMPANY

~~###~~ Kewanee Oil

CONTRACTOR

Lewis

NE Emmeram


_____ Ft. from N. Line

_____ Ft. from S. Line

_____ Ft. from E. Line

_____ Ft. from W. Line

NW SW SW

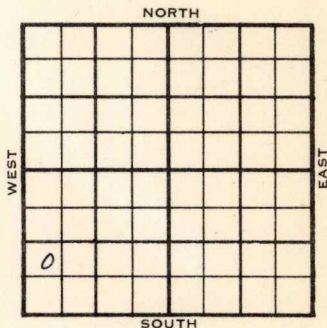

	ELEVATION	REPORT
1956		
1-5	Comm. 12-30-55 8" @ 250/180 Drlg. 2200	

County

~~Ellis~~

Elev.

Sec.

26

Twp.

12

Rge.

16W

Company

Kewanee Oil

Farm Name

Sitz "B"

No.

5

TOPS

DEPTH

LOG

DATUM

Loc. in Sec.

Anh.

NW SW SW

Tp.

H.

Tr.

Dg.

Bl.

L.

K.C.

B.K.C.

Ce.

C.

M.

M.

K.

Mz.

Mq.

V.

S.

S.

A.

R.

P.E.

G.

T.D.

Geol.

Contr.

Lewis

Pool

NE Emeram

FIRST REPORT

JAN 5 56

Date Comm.

12-30-55

8" @ 250/180

d rlg. 2200

County Ellis Elev. 2018
 Sec. 26 Twp. 12 Rge. 16W
 Company Keweenaw Oil
 Farm Name Sitz "B" No. 5

TOPS	DEPTH	LOG	DATUM	Loc. in Sec.
Ant.	1170			NW SW SW
Top				
H.	3171			
Tc. <u>dodge</u>	3194			
Dp.				
Bl.				
L.	3222		1204	Geol.
K.C.				Contr.
R.K.C.				
Ce.				Lewis
C.				
M.				
M.				Pool
K.				NE Emeram
Ms.				
Ne				
V.				
S.				
S.				
A.	3485		1467	COMPLETE
R.				
Pe.				
G.				
10	3487			

Date Comm. 12-30-55

FEB 2 2 1956

8" @ 250/180 drlg. 2200 JAN 11 '56

DST 3222-60 1hr rec 20' MD

BHP 550 @ 3313 JAN 18 '56

5 1/2 3486 JAN 25 '56 FEB 1 '56 ✓ FEB 8 '56 ✓

FEB 15 '56 ✓ FEB 22 '56 60 DD 3491 TD @

R4 60 + 40 BW in 3 hrs. 1/4

2 1/2 BFPk 870 wtr 3 hrs.

12 @ 4 1/2 B0 + 1/2 BWPk 17

hrs. Pol. P. 50 Bapd + 2370 wtr