


Map No. Kansas Sec. 21 Twp. 33 R. 3^E
Well No. 6 Wm Snyder Farm
Waite Phillips Company

NORTH

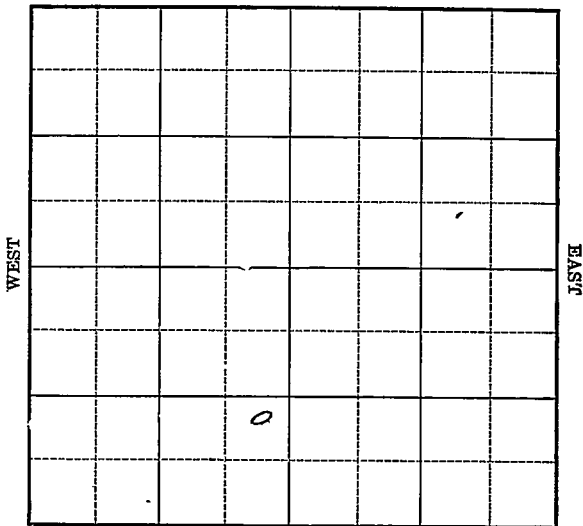

SOUTH

Location _____

Drilling Remarks

RECORD

Cased _____ in. _____ ft.
Sand _____
Gas _____
Oil _____
Total Depth _____

Rig Up _____

Drilling Remarks

PRODUCTION

1st 24 hrs. Nat. _____
1st 24 hrs. after shot _____
Gas _____ cu. ft.
Dry Hole _____
Abandoned _____

Map No. **KANSAS** Sec. 21 Twp. 33 R. 3E

Well No. 6 Wm Snyder
Waite Phillips Company
 Contractor

SECTION PLAT

-----Ft. from N. Line
990 Ft. from S. Line
330 Ft. from E. Line
 -----Ft. from W. Line

	0		

FIRST REPORT

Location -----
 Rig up -----
 Drilling and Remarks:

RECORD

Cased ----- in., ----- ft.
 Sand -----
 Gas -----
 Oil -----
 Total Depth -----

PRODUCTION

1st 24 hrs. Nat. -----
 1st 24 hrs. after shot -----
 Gas ----- Cu. Ft.
 Dry Hole -----
 Abandoned -----

Cellar

Date

SEP 16 1925

S. J. LEWIS

Scout

192

