


Section 27 Township 12 Range 16W

Well No. 8 Froelich

Company Kewanee Oil

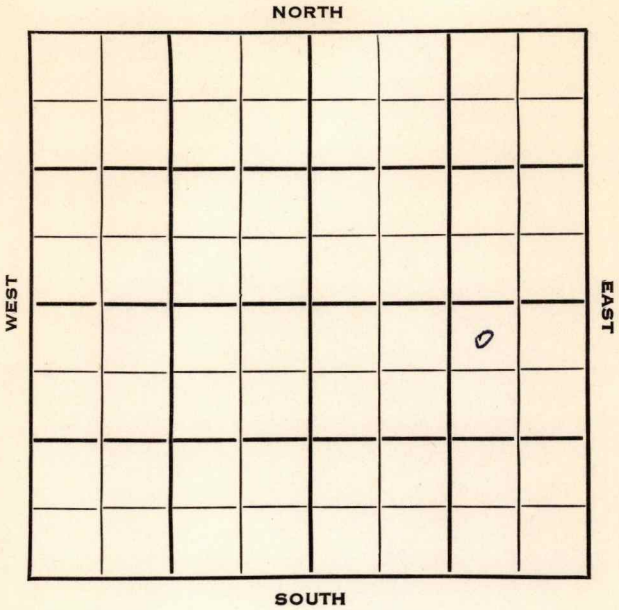

Ellis

KANSAS

SEC.	TWP.	R.
27	12	16W ✓

WELL NO. _____

COMPANY #8 **Froelich** FARM

CONTRACTOR **Kewanee Oil**

Lewis Drlg.


NE Emmeram Pool

330 Ft. from N. Line

_____ Ft. from S. Line

990 Ft. from E. Line

_____ Ft. from W. Line

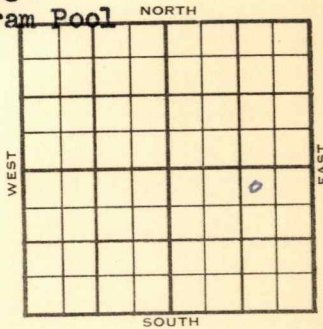

NW NE SE

1954	ELEVATION	REPORT
	1972'	

4/21 Spud 4-19-54
10" @ 243'
WOC.

5/19 Spud 4-19-54 Oil well TD 3450
10" @ 243 Anhy 1120 Heeb 3122
Edge 3149 Lans 3176 Arb. 3442
TD 3449 7" @ 3443 CO to 3449
FU 600' fluid 2 1/2 hr. DD 3450
P/5 BFPH 7 hr. 18% wtr.
Comp. 83 BOPD 17 BW

COMPLETED

