

KANSAS

Form 51-5M-7-39-Palace


Russell

Section 15 Township 15 Range 13-W

Well No. #2 Sellens

Company Sinclair Prairie

NORTH Coralena Pool

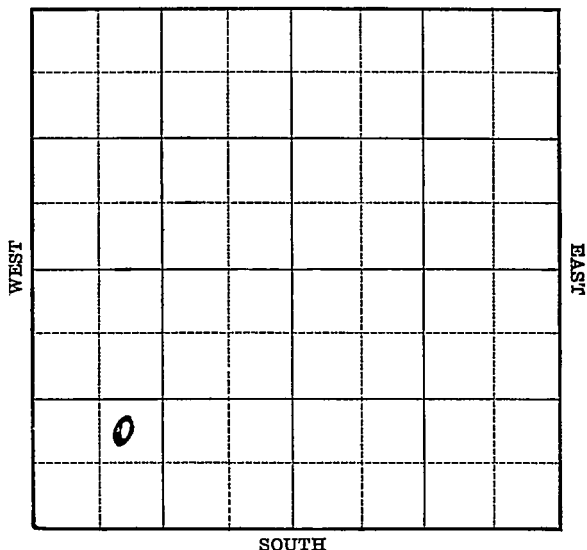

COMPLETED

Map No. 73 Sec. 15 Twp. 15 R. 13WWell No. 2 SellensSinclair Prairie

Company

Contractor

FIRST REPORT

NE SW SW

Ft. from N. Line

990 Ft. from S. Line

Ft. from E. Line

990 Ft. from W. Line

SECTION PLAT

o			

CORALENA POOL

Location _____

Rig up _____

Drilling and Remarks:

S.H. 70'

RECORD

Cased _____ in., _____ ft.

Sand _____

Gas _____

Oil _____

Total Depth _____

PRODUCTION

1st 24 hrs. Nat. _____

1st 24 hrs. after shot _____

Gas _____ Cu. Ft.

Dry Hole _____

Abandoned _____

Date

MAR 20 1940 19

S. J. LEWIS

Scout

Map No. 72 Sec. 15 Twp. 15 R. 13WWell No. 2 SellensSinclair Prairie

Company

Contractor

COMPLETED

NE SW SW

Ft. from N. Line

990 Ft. from S. Line

Ft. from E. Line

990 Ft. from W. Line

CORALENA POOL

SECTION PLAT

Location _____

Rig up _____

Drilling and Remarks:

*Art 3329**8" C 3380**2000 and**Echometer Log**1391*

RECORD

Cased _____ in., _____ ft.

Sand _____

Gas _____

Oil _____

Total Depth 3333

PRODUCTION

1st 24 hrs. Nat. _____

1st 24 hrs. after shot _____

Gas _____ Cu. Ft.

Dry Hole _____

Abandoned _____

Date

APR 17 1940 19

S. J. LEWIS Scout