


Section 22 Township 33 Range 3E

Well No. #1 Lester

Company B. B. Blair

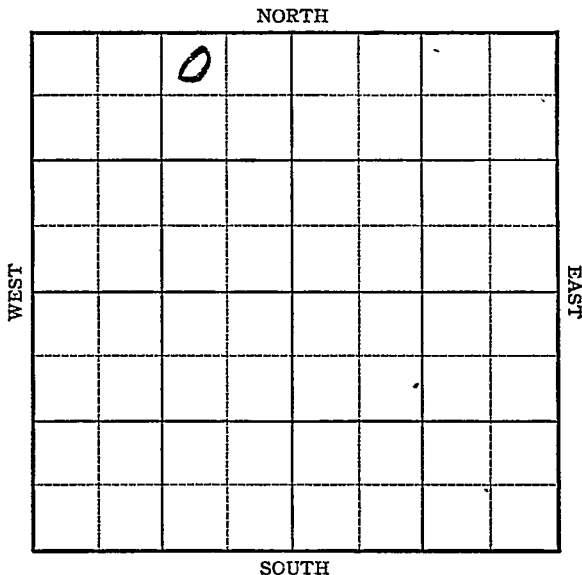

Sec. 22 Twp. 33 R. 3E

Well No. #1 Lester Farm

B. B. Blair Company


Miscellaneous

330 Ft. from N. Line

_____ Ft. from S. Line

990 Ft. from E. Line

_____ Ft. from W. Line

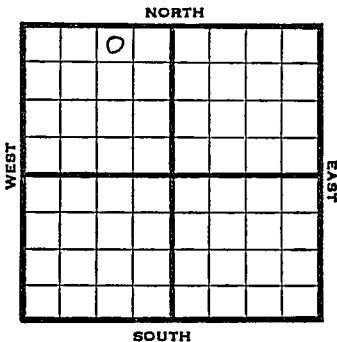

NW NE NW

REPORT

1946

1/9 10" @ 105
Drlg. 1180'

1/17 Drlg. 2350'

1/23 Bart 3234
Miss. 3270
TD 3275'

ABANDONED

NSAS

Kansas

Pool Name Miscellaneous

Map No. 1 Sec. 22 Twp. 33 R. 3E

Well No. 1 Lester

B. B. Blair Company

FIRST REPORT Contractor

NW NE NW

SECTION PLAT

330 Ft. from N. Line

Ft. from S. Line

990 Ft. from E. Line

Ft. from W. Line

	o		

Cowley County

RECORD

Location _____

Cased _____ in., _____ ft.

Rig up _____

Sand _____

Drilling and Remarks:

Gas _____

10" - 105

Oil _____

1180

Total Depth _____

PRODUCTION

1st 24 hrs. Nat. _____

1st 24 hrs. after shot _____

Gas _____ Cu. Ft.

Dry Hole _____

Abandoned _____

Date

JAN 9 1946 19

S. J. LEWIS Scout

KANSAS

Kansas Pool Name Miscellaneous

Map No. 1 Sec. 22 Twp. 33 R. 3E

Well No. 1 Lester

B. B. Blair Company

ABANDONED Contractor

NW NE NW

SECTION PLAT

	o		

330 Ft. from N. Line

_____ Ft. from S. Line

990 Ft. from E. Line

_____ Ft. from W. Line

Cowley County

Location _____

Rig up _____

Drilling and Remarks:

Bar 3234
Miss 3270

RECORD

Cased _____ in., _____ ft.

Sand _____

Gas _____

Oil _____

Total Depth 3275

PRODUCTION

1st 24 hrs. Nat. _____

1st 24 hrs. after shot _____

Gas _____ Cu. Ft.

Dry Hole _____

Abandoned _____

Date

JAN 23 1946 19

S. J. LEWIS Scout