

Section 27 Township 12 Range 16W

Well No. #5 Froelich "C"

Company Kewanee Oil

NORTH

| | | | | | | | |
|--|--|--|--|--|--|--|---|
| | | | | | | | |
| | | | | | | | 0 |
| | | | | | | | |
| | | | | | | | |
| | | | | | | | |
| | | | | | | | |
| | | | | | | | |
| | | | | | | | |

WEST

EAST

SOUTH

Sec. 27 Twp. 12 R. 16W

Well No. #5 Froelich "C" Farm

Kewanee Oil Company

Gross Drlg. Contractor


990 Ft. from N. Line

Ft. from S. Line

330 Ft. from E. Line

Ft. from W. Line

SE NE NE

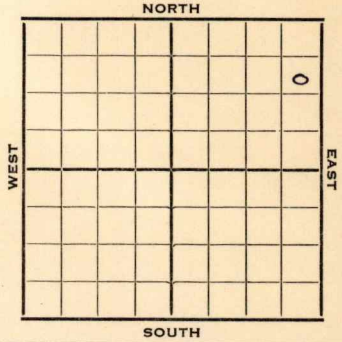

1952

Elev. 1977'

REPORT

5/14 Spud 5-11-52
10" @ 250' WOC

5/21 Anhy 1132 Drlg. 3050'
5/28 DST 3426-46, 1/2 hr, 5' M O#
Arb. 3454' RTD3459' 7" @ 3457
MICT

6/11 Spud 5-11-52
Oil well TD 3463' 10" @ 250
Anhy 1132'
DST 3426-46 open 1/2 hr. rec 5' mud
Arb. 3454' TD 3463 7" @ 3457
Heeb 3137' Dodge 3162' Lans. 3185'
DP to 3463' 1000 A
Comp. 59 BOPD

COMPLETED

