


Section.....16.. Township.....15.. Range.....13-W

Well No.1 "A" Seigfried (twin to lost hole)

CompanyCoralena.....

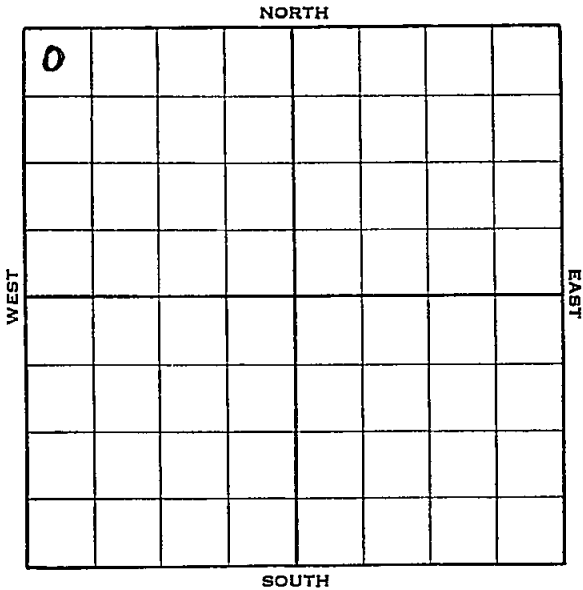

Sec. 16 Twp. 15 R. 13-W


Well No. #1 "A" Seigfried (Twin to Lostm
Coraleana Hole)
Company

355 Ft. from N. Line

_____ Ft. from S. Line

330 Ft. from E. Line

_____ Ft. from W. Line

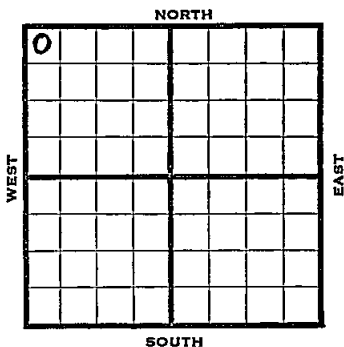

1938	REPORT
10/12	Csg. Collapsed on old hole at 3086'. Skidded rig.
10/14	Lost hole. Skid rig.
10/21	12" - 147'. Dlg. 850'.
10/28	Dlg. 2630'.
11/4	Lans. 3050'. T. D. 3080'. 7" - 3060'. RUST.
11/12	Pay 3080-90'. 1100' oil in 8 hrs. 7" - 3091' cemented. T. D. 3126'. C. O.
11/18	" " " "
11/25	6" - 3118'. 10,000 acid. 3118-26'. 5000 acid. 3080-90'.
11/30	6" - 3118'. Lansing 3050'. T. D. 3126'. 15000 acid. Potential 1635 bbls.
COMPLETED	

Map No. _____ Sec. 16 Twp. 15 R. 13W

Well No. 1 "A" Seigfried (twin to lost hole)
Coralena Company

Contractor _____

FIRST REPORT

NW/C

355 Ft. from N. Line

_____ Ft. from S. Line

330 Ft. from E. Line

_____ Ft. from W. Line

SECTION PLAT

0			

Location _____

Rig up _____

Drilling and Remarks:

Csg. Collapsed
 on old hole
 @ TD 3086

Skidded Rig.

RECORD

Cased _____ in., _____ ft.

Sand _____

Gas _____

Oil _____

Total Depth _____

PRODUCTION

1st 24 hrs. Nat. _____

1st 24 hrs. after shot _____

Gas _____ Cu. Ft.

Dry Hole _____

Abandoned _____

Date

OCT 12 1938

19

H. D. Hatfield

Scout

Map No. 73 Sec. 16 Twp. 15 R. 13WWell No. 1 "A" Seigfried (Twin to _____
Coralena Lost Hole
Company

Contractor _____

COMPLETED

NW/C

355 Ft. from N. Line

_____ Ft. from S. Line

330 Ft. from E. Line

_____ Ft. from W. Line

SECTION PLAT

0			

Location _____

Rig up _____

Drilling and Remarks:

15000 acidPOT 1635

RECORD

Cased 6 in., 3118 ft.Sand LENS 3050

Gas _____

Oil _____

Total Depth 3126

PRODUCTION

1st 24 hrs. Nat. _____

1st 24 hrs. after shot _____

Gas _____ Cu. Ft.

Dry Hole _____

Abandoned _____

Date

NOV 30 1938

19

H. D. Hatfield Scout

Trp. Pool

Co. Fac

O.W.W.O.

S-513-B

County Russell Elev. 1887
 Sec. 16 Twp. 15 Rge. 13W
 Company C R A
 Farm Name Geo. Bitter No. 1-A

TOPS	DEPTH	LOG	DATUM
Anh.			
Tp.			
H.			
Tr.			
Dg.			
B.L.			
L.			
K.C.	<u>3052</u>		
B.K.C.			
Ce.			
C.			
M.			
M.			
K.			
Mz.			
Mq.			
V.			
S.			
S.			
A.			
R.			
Pf.			
G.			
T.D.			

Loc. in Sec. NW NW NW
O.W.W.O.

Geol. _____
 Contr. _____
 Pool Trapp

FIRST REPORT
 AUG 27 58
 COMPLETED

Date Comm. OTD 3126 5" @ 3060 DD 3159
2000 A Comp. 14 bopd 2 3/4 bwpd

Co.
Lse.
No.
Sec.
T.
R.