


Section 27 Township 12 Range 16-W

Well No. #1 Froelich "C"

Company Kewanee Oil

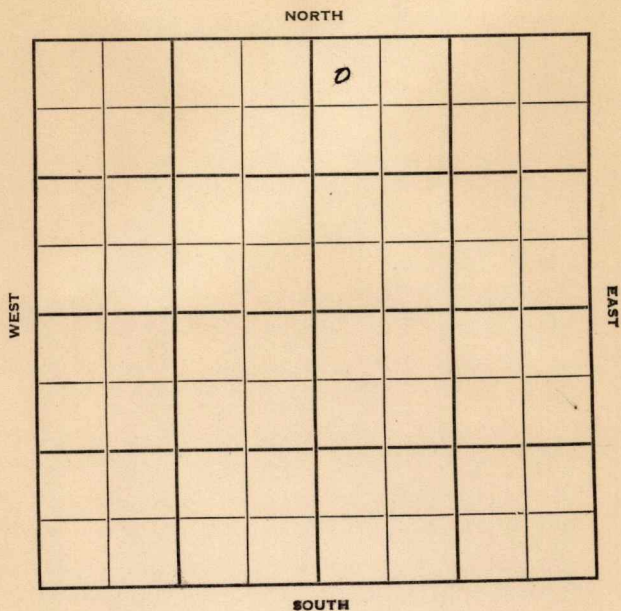

KANSAS

Ellis
16-W

Sec. 27 Twp. 12 R. 16-W

Well No. #1 Froelich "C" ☒ Farm

Kewanee Oil Company

Contractor

Catherine


330 Ft. from N. Line

Ft. from S. Line

Ft. from E. Line

330 Ft. from W. Line

NW NW NE
Oil Well

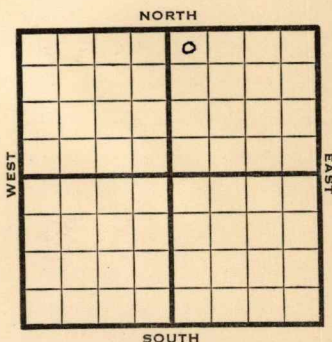

1950 Elev 1984 REPORT

7/12 Location

9/13 8" @ 1138

Anhy 1126

Lans 3191

5" @ 3462

TD 3465

FU 165' oil 2 hr DD 3468

FU 400' oil 4 hr

DD 3471 FU 1475' fluid

24 hr 500 A Comp 151 bopd

Completed TD 3471

COMPLETED

Heeb 3145

Arb 3462-63

Map No. _____ Sec. 27 Twp. 12 R. 16WWell No. 1 Froelich "C"

_____ Kewanee Oil _____ Company

_____ Contractor


NW NW NE

SECTION PLAT

330 Ft. from N. Line

_____ Ft. from S. Line

_____ Ft. from E. Line

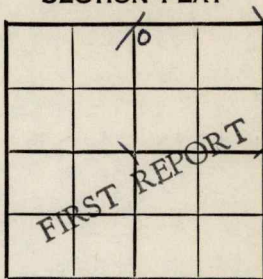330 Ft. from W. Line

Ellis County

Location X

Rig up _____

Drilling and Remarks:

RECORD

Cased _____ in., _____ ft.

Sand _____

Gas _____

Oil _____

Total Depth _____

PRODUCTION

1st 24 hrs. Nat. _____

1st 24 hrs. after shot _____

Gas _____ Cu. Ft.

Dry Hole _____

Abandoned _____

Date

JUL 12 1950 19J. E. TYRA Scout

County Ellis State KansasSec. 27 (Blk.
Twp.) 12 (Sur.
Rge.) 16W Map No.Operator Kewanee OilWell No. 1 Farm Froelich "C"Elev. 1984 Location NW NW NE

330 Ft. From N Line NE330 Ft. From W Line Quarter

1st. Report

Completion SEP 13 1950

Remarks

Catherine Pool

Spudding Date

Drilg. Data Oil well TD 34718" @ 1138 Anhy 1126 Heeb. 3145Lans 3191 Arb. 3462-63 5" @ 3462TD 3465 FU 165' oil 2 hr. DD 3468FU 400' oil 4 hr. DD 3471 FU 1475' fluid24 hr. 500 A Comp. 151 bopd

J. E. TYRA