


Section 15 Township 15 Range 13 W

Well No. # 3 Sellens

Company Isern Bros.

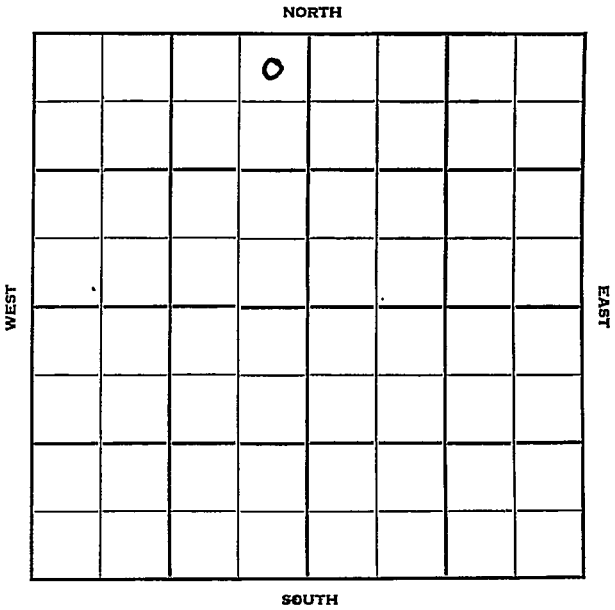

Sec. 15 Twp. 15 R. \_\_\_\_\_

Well No. #3 Sellens Farm

Isern Bros. Company

Isern Bros. Contr. Contractor

Trapp Pool


330' Ft. from N. Line

\_\_\_\_\_ Ft. from S. Line

330' Ft. from E. Line

\_\_\_\_\_ Ft. from W. Line

NE NE NW

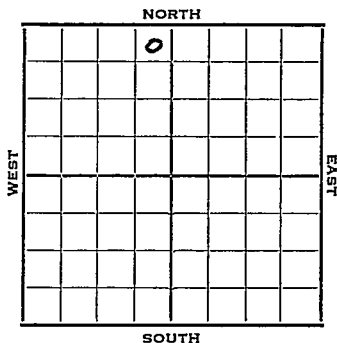

1952

Elev. 1874' REPORT

6/4

Spud 6-1-52  
8" @ 165

WOC

6/11 RTD 3383' Set pipe

6/18 Spud 6-1-52

Oil Well TD 3383  
8" @ 165

Tarkio 2499

DST 2465-2524 opn 1 hr. Rec. 420'

O&GCM 60' so & gcm

Top 2743 Heeb. 2977 Tor. 2995

Lans. 3054

DST 3239-52 opn 3/4 hr. Rec. 8' mud

BKC 3312 Cong. 3336 Arb. 3377

TD 3383 5" @ 2575 48/2501-11

S/28 go 6 gwph Hydro S/5 boph

Comp. 30 bopd 15% wtr.

**COMPLETED**

County Russell State Kansas

Sec. 15 (Blk. Twp.) 15 (Sur. Rge.) 13W Map No.

Operator Isern Bros.

Well No. 3 Farm Sellens

Elev. Location NE NE NW

		o			

350 Ft. From N Line NW

330 Ft. From E Line Quarter

Ist. Report JUN 4 1952

Completion \_\_\_\_\_

Remarks \_\_\_\_\_

Isern Bros. - Contr.

Spudding Date 6-1-52

Drlg. Data Trapp Pool

8" @ 165 WOC

