


Section 15 Township 15 Range 13W

Well No. 6 Sellens

Company Sinclair-Prairie

Trapp

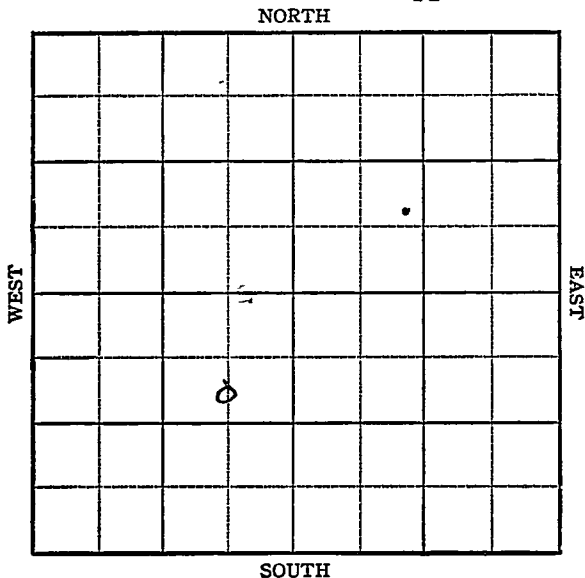

Sec. 15 Twp. 15 R. 13-W ✓

Well No. #6 Sellens Farm

Sinclair-Prairie Company


990 Ft. from N. Line

 Ft. from S. Line

670 Ft. from E. Line

 Ft. from W. Line

C S L NE SW

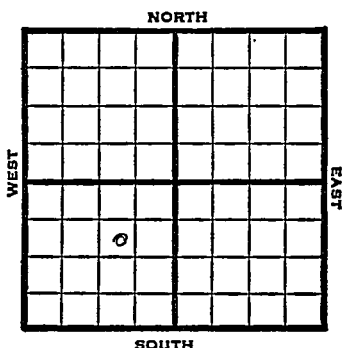

1949

Elev 1875' REPORT

1/26

Location
SWD

2/2

10" @ 585'

2/9

Drlg 3335'

2/16

Drlg 3545'

2/23

"

3/2

Arb. 3345'

Quartzite 3645'

TD 3670 fsg.

3/8

"

3/16

TD 3670'

Reagan 3450'

5" @ 3535'

Quartzite 3535

SWD

Aband.

ABANDONED

Map No. _____ Sec. 15 Twp. 15 R. 13W

Well No. 6 Sellens

Sinclair-Prairie


Company

FIRST REPORT

Contractor

C S L F E SW

SECTION PLAT

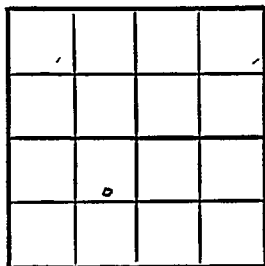

990 Ft. from N. Line

Ft. from S. Line

670 Ft. from E. Line

Ft. from W. Line

Russell County

Location X

Rig up

Drilling and Remarks:

SWD

RECORD

Cased _____ in., _____ ft.

Sand

Gas

Oil

Total Depth

PRODUCTION

1st 24 hrs. Nat. _____

1st 24 hrs. after shot _____

Gas _____ Cu. Ft.

Dry Hole

Abandoned

Date

JAN 26 1949

19

S. J. LEWIS

Scout

Kansas

Trapp Pool


Map No. 73 Sec. 15 Twp. 15 R. 13WWell No. 6 Sellens SWDSinclair-Prairie

Company

ABANDONED

Contractor

C S L NE SW

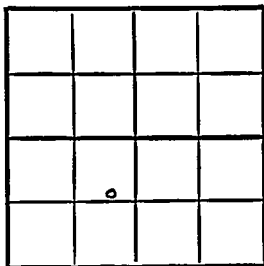E. 1/8 SW
SECTION PLAT990 Ft. from N. Line Ft. from S. Line670 Ft. from E. Line Ft. from W. LineRussell CountyLocation Rig up

Drilling and Remarks:

Pragan 3450
5" 3535
Quartzite 3535-
SWD

RECORDCased in., ft.Sand Gas Oil Total Depth 3670**PRODUCTION**1st 24 hrs. Nat. 1st 24 hrs. after shot Gas Cu. Ft.Dry Hole Abandoned

Date

MAR 16 1949

19

J. LEWIS

Scout