

DX 78-1


Russell

KANSAS

Section 15 Township 15 Range 13 W

Well No. # 7 Sellens

Company Sinclair

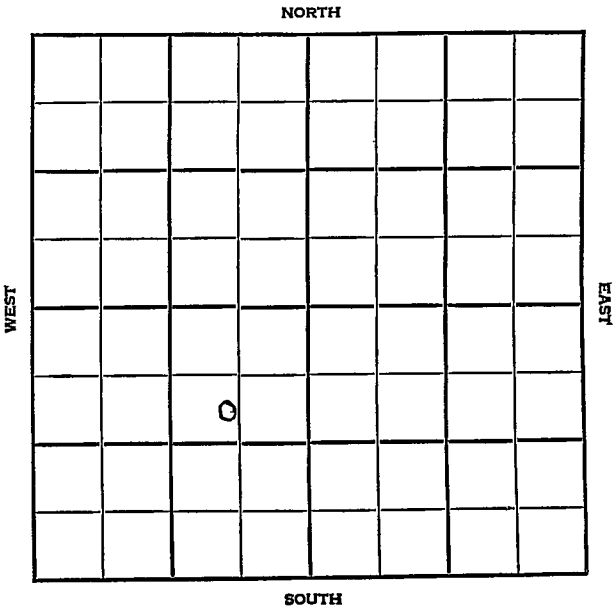

Russell KANSAS


SEC.	TWP.	R.
15	15	13W

WELL NO. 7 Sellens FARM

COMPANY Sinclair

CONTRACTOR Brack

940 Ft. from N. Line
 Ft. from S. Line
 720 Ft. from E. Line
 Ft. from W. Line

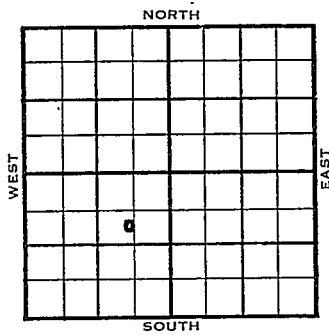

SW NE SW

	ELEVATION	REPORT
1954	1874'	

8/18 Spud 8-14-54
 8" @ 1030'

10/13 Spud 8-14-54
 SWD Well.
 TD 3734'
 8" @ 1030'
 Heeb 2979', Doug 3014', Br. Lime 3051'
 Lans 3071', Cong 3322', ReArb 3330'
 Arb 3340'
 TD 3440'
 7" @ 3439'
 Reagan 3460'
 TD 3734'
 Comp for SWD Well.
 Input 360 bwph

ABANDONED

