


Section 27 Township 12 Range 16W

Well No. #4 Froelich "E"

Company Kewanee Oil

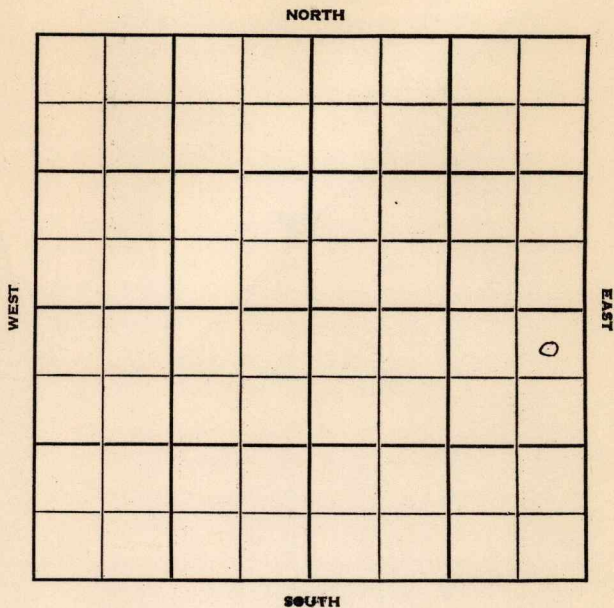

Ellis

KANSAS

Sec. 27 Twp. 12 R. 16W

Well No. #4 Froelich "E" Farm

Kewanee Oil Company

Gross Drlg. - Contr. Contractor

Emmerman Pool


330' Ft. from N. Line

\_\_\_\_\_ Ft. from S. Line

330' Ft. from E. Line

\_\_\_\_\_ Ft. from W. Line

NE NE SE

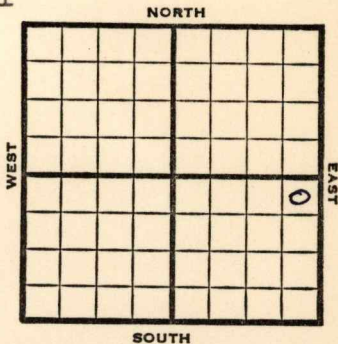

1951

Elev. 2038' REPORT

9/5  
10/17

RUR

Spud 9-14-51

Oil Well TD 3507

8" @ 244

Heeb. 3186 Dodge 3204

Lans. 3233 BKC 3478

Arb. 3503-05

7" @ 3503 TD 3507

S/299 bo 10 hr.

P/379 bo 25 hr.

Comp. 280 bopd

**COMPLETED**



