KANSAS

Russell

FORM 51 5M 4-41 PETROL

Section 16 Township 15 Range 13-W

Well No. 1 Holland

Company Coralena

NORTH Coralena Pool

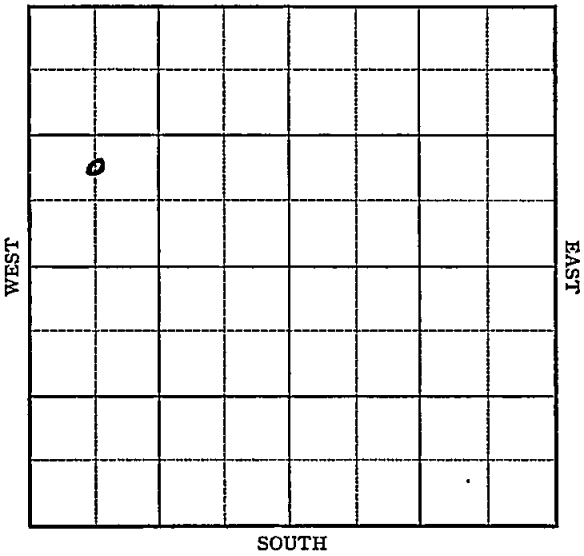

FORM 252-A 5M 1-41, PETROL **KANSAS** Russell

Sec. 16 Twp. 15 R. 13-W

Well No. #1 Holland Farm

Coralena Company

(Coralena)

Ft. from N. Line

990 Ft. from S. Line

Ft. from E. Line

660 Ft. from W. Line

Elev. 1882

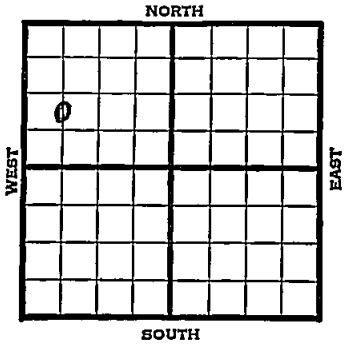

1941	REPORT
5/7	Derrick.
5/15	10" - 200' Anhy 850'
	Drlg. 2130'
5/22	Lans. 3049' 5" - 3080'
	T.D. 3086' RUST.
5/28	1500' oil 12 hours 4000 acid.
6/4	Lans. 3049'
	5" - 3080'
	T.D. 3086'
	4000 acid.
	Depthograph potential 9369 bbls.
	Maximum 3000 bbls.
	39.8 Gravity
	COMPLETED

Form 26—200 Bks.—1-40—Palace Russell KANSAS

Map No. 73 Sec. 16 Twp. 15 R. 13W

Well No. 1 Holland

Coralena Company

FIRST REPORT Contractor

C N L SW NW

Ft. from N. Line

990 Ft. from S. Line

Ft. from E. Line

660 Ft. from W. Line

CORALENA POOL

SECTION PLAT

Location

Rig up

Drilling and Remarks:

Derrick

RECORD

Cased in., ft.

Sand

Gas

Oil

Total Depth

PRODUCTION

1st 24 hrs. Nat.

1st 24 hrs. after shot

Gas Cu. Ft.

Dry Hole

Abandoned

Date

MAY 7 1941 19

S. J. LEWIS Scout

Form 26—200 Bks.—1-40—Palace Russell KANSAS

Map No. 73 Sec. 16 Twp. 15 R. 13W

Well No. 1 Holland

Coralena Company

COMPLETED Contractor

C N L SW NW

Ft. from N. Line

990 Ft. from S. Line

Ft. from E. Line

660 Ft. from W. Line

CORALENA POOL

SECTION PLAT

Location

Rig up

Drilling and Remarks:

Lane 3049
5" @ 3080
4000 acid
Depth Pot 9369
Max 3000
39 E Gr

RECORD

Cased in., ft.

Sand

Gas

Oil

Total Depth 3086

PRODUCTION

1st 24 hrs.-Nat.

1st 24 hrs. after shot

Gas Cu. Ft.

Dry Hole

Abandoned

Date

JUN 4 1941 19

S. J. LEWIS Scout