

Cowley


KANSAS

SECTION 23 TOWNSHIP 33 RANGE 3E

WELL NO. #1 Lester

COMPANY L.C. Smitherman

NORTH

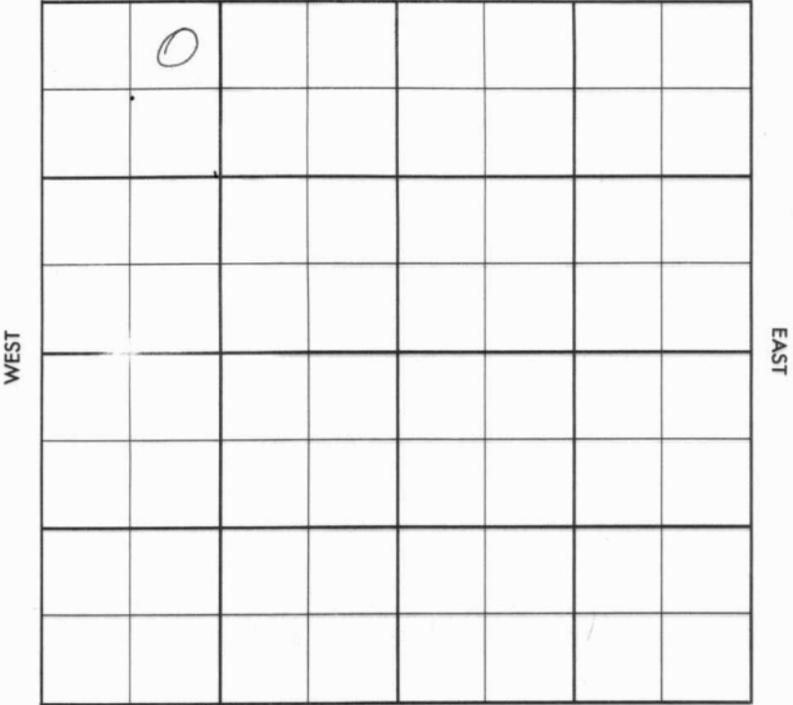

SOUTH

County Cowley Elev. _____
 Sec. 23 Twp. 33 Rge. 3E
 Company L. C. Smitherman
 Farm Name Lester No. 1

TOPS	DEPTH	LOG	DATUM
Anh.			
TP.			
H.			
Tr.			
Dg.			
Bl.			
L.			
K.C.			
B.K.C.			
Ce.			
C.			
M.			
M.			
K.			
Mz.			
Me.			
V.			
S.			
S.			
A.			
R.			
PE.			
G.			
T.D.			

Loc. in Sec. NE NW NW
 Geol. _____
 Contr. _____
 Co. Tools _____
 Pool _____
 Ext. to Graham _____

 No. _____
 Sec. _____
 T. _____
 R. _____

Date Comm. 12-15-56
8" @ 75 w/60, Drlg. 664

29

Co.

County Cowley Elev. 1159
 Sec. 23 Twp. 33 Rge. 3E
 Company L. C. Smitherman
 Farm Name Lester No. 1

TOPS	DEPTH	LOG	DATUM
Anh.			
TP.			
H.			
Tr.			
Dg.			
Bl.	<u>3285</u>		
L.			
K.C.			
B.K.C.			
Ce.			
C.			
M.			
M.			
K.			
Mz.			
Mq.			
V.			
S.			
S.			
A.			
R.			
Pe.			
G.			
T.D.	<u>3293</u>		

Loc. in Sec. NE NW NW
 Geol. _____
 Contr. Co. Tools
 Pool _____
 Ext. to Graham

Lse.



No.

Date Comm. 12-15-56

Sec.

8" @ 75 w/60, Drlg. 66A DEC 26 56

5 1/2 @ 3284 JAN 2 '57 co 3293

est 1/2 Boph Frac p.

75 Bopd + 150 Bwpd

p. 25 Bopd + 40 Bwpd.

T.

R.