

Russell

KANSAS

SECTION 16 TOWNSHIP 15S RANGE 13W

WELL NO. #8 Holland


COMPANY / C. R. A. Kepler & Boone

NORTH

N/2 S/2 NW

WEST

EAST

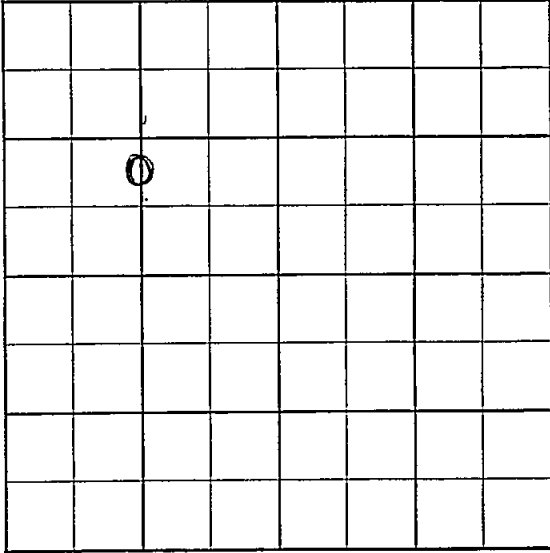

SOUTH

~~Tr. - 100 ft~~      ~~Post - 100 ft~~  
~~Co. - 100 ft~~      ~~Post - 100 ft~~

S-513-B

County Russell Elev. \_\_\_\_\_  
 Sec. 16 Twp. 15 Rge. 13W  
 Company C. R. A., Kepler & Boone  
 Farm Name Holland No. 8

TOPS	DEPTH	LOG	DATUM
Anh.			
Tp.			
H.			
Tr.			
Dg.			
B.L.			
L.			
K.C.			
B.K.C.			
Ce.			
C.			
M.			
M.			
K.			
Mz.			
Mq.			
V.			
S.			
S.			
A.			
R.			
Pf.			
G.			
T.D.			

Loc. in Sec. \_\_\_\_\_  
N/2 S/2 NW  
 Geol. \_\_\_\_\_  
 Contr. \_\_\_\_\_  
Shields  
 Pool \_\_\_\_\_  
Trapp

**FIRST REPORT**  
 APR 9 1938

Date Comm. \_\_\_\_\_  
WORT

\_\_\_\_\_

\_\_\_\_\_

\_\_\_\_\_

\_\_\_\_\_

\_\_\_\_\_

\_\_\_\_\_

Co. \_\_\_\_\_  
 Use \_\_\_\_\_  
 No. \_\_\_\_\_  
 Sec. \_\_\_\_\_  
 T. \_\_\_\_\_  
 R. \_\_\_\_\_

Twp. X Pool       
 Co.      Facet X

S-513-B

County Russell Elev 1974 ft 193.41  
 Sec. 16 Twp. X Rge. 13W  
 Company C. R. A., Kepler & Boone  
 Form Name Holland No. 8

TOPS	DEPTH	LOG	DATUM
Anh.	853		
Tp. <u>Tarkio Li</u>	2476	2470	
H. <u>TP</u>	2740	2739	
Tr. <u>H</u>		2971	
Dg. <u>TR</u>		2986	
B.L.			
L.		3038	
K.G.			
B.K.C.			
Ce.			
C.			
M.			
M.			
K.			
M.			
Mq.			
V.			
S.			
A.		3312	
R.			
Pf.			
G.			
T.D.	3319	3319	

Loc. in Sec. N/2 S/2 NW  
 Geol.       
 Contr. Shields  
 Pool Trapp  
 COMPLETE  
 MAY 21 '58

Date Comm. 4-16-58  
 WORT APR 18 '58 APR 23 '58 8" 863/450 Ø 2693  
 APR 30 '58 Ø 2943 MAY 7 '58 end 2983  
 -3296 full rec. Log 5" 3316/225  
 MAY 14 '58 CO 3319 FU 2000' FID NT  
 E 16.70 go + 29w NT pop P74  
 BO NW 24 hrs + stg MAY 2: a  
 P 7780 NW 24 hrs

Co.  
 Lse.  
 No.  
 Sec.  
 T.  
 R.