

KANSAS

KANSAS

Company C. R. A.

A 7x7 grid map with 'NORTH' at the top, 'SOUTH' at the bottom, 'WEST' on the left, and 'EAST' on the right. The word 'Trapp' is written in the top-left corner. A small circle is in the bottom-right cell, and a small dot is in the cell to its left.

Russell ✓

Sec. 17 Twp. KANSAS 15 R. 13W

Well No. #5 Tom Sellens Farm

C.R.A. Company

Trapp


 Ft. from N. Line

330 Ft. from S. Line

990 Ft. from E. Line

 Ft. from W. Line

SW SE SE

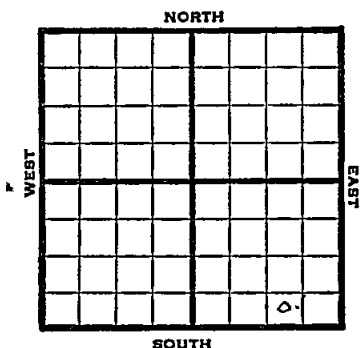

1947

Elev. 1848 REPORT

8/6 Location

8/13 8" @ 850'
Drlg. 2095'

8/20 Dodge 2993'
Drlg. 3028'

8/27 Lans. 3044'
5" @ 3113
TD 3114
24 shots
3065-74
4000 acid
swb 191 bbls oil 31 hrs.

9/3 " "

9/10 Lans. 3044'
5" @ 3113'
Perf.
4000 acid
Pump 91 Pot
40.9 Gr.
TD 3114'

COMPLETED

Kansas Trapp

Map No. _____ Sec. 17 Twp. 15 R. 13W

Well No. 5 Tom Sellens

C R A

Company

FIRST REPORT

Contractor

SW SE SE

SECTION PLAT

_____ Ft. from N. Line

330 Ft. from S. Line

990 Ft. from E. Line

_____ Ft. from W. Line

Russell County

Location X

Rig up

Drilling and Remarks:

RECORD

Cased _____ in., _____ ft.

Sand _____

Gas _____

Oil _____

Total Depth _____

PRODUCTION

1st 24 hrs. Nat. _____

1st 24 hrs. after shot _____

Gas _____ Cu. Ft.

Dry Hole _____

Abandoned _____

Date

AUG 6 1947 19 S. J. LEWIS Scout

Map No. 73 Sec. 17 Twp. 15 R. 13W

Well No. 5 Tom Sellens

C R A Company

COMPLETE Contractor

SW SE SE


E. 1848
SECTION PLAT

 Ft. from N. Line

330 Ft. from S. Line

990 Ft. from E. Line

 Ft. from W. Line

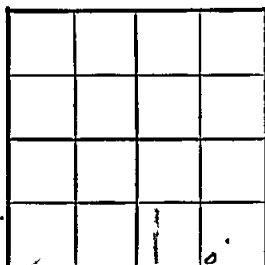

Russell County

Location

Rig up

Drilling and Remarks:




RECORD

Cased in., ft.

Sand

Gas

Oil

Total Depth 3114

PRODUCTION

1st 24 hrs. Nat.

1st 24 hrs. after shot

Gas Cu. Ft.

Dry Hole

Abandoned

Date

SEP 10 1947 19

S. J. LEWIS

Scout