


Section 16 Township 15 Range 13-W

Well No. #3 Holland

Company Coralena

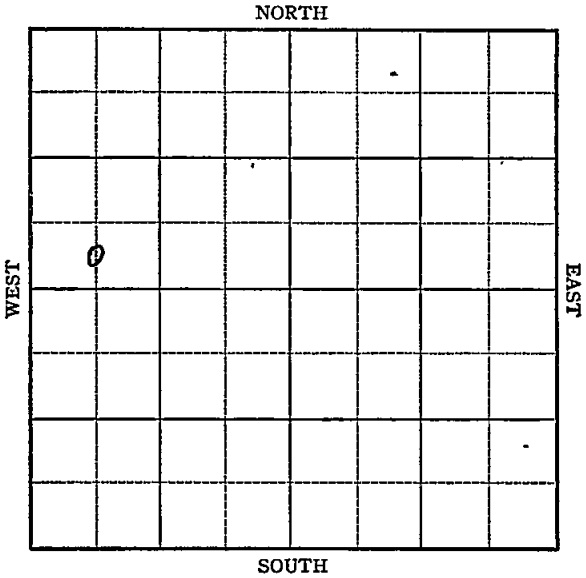

Sec. 16 Twp. 15 R. 13-W

Well No. #3 Holland Farm

Coralena Company

(Trapp)


 Ft. from N. Line

330 Ft. from S. Line

 Ft. from E. Line

660 Ft. from W. Line

Elev. 1868

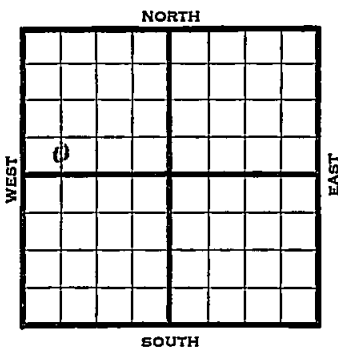

1941	REPORT
11/19	10" - 200'
	Drlg. 250'
11/26	Anhy 830' Drlg. 2731'
12/4	Lans. 3037' 5" - 3091'
	T.D. 3121' S.S.O.
12/11	TD 3121 Pump 11 oil PH 24 Hrs.
12/18	" " " " " "
12/23	Lans. 3037'
	5" - 3091'
	T.D. 3121'
	4000 acid.
	Potential 58 bbls., pump.
	39. Gravity
	COMPLETED

Map No. K-23 Sec. 16 Twp. 15 R. 13WWell No. 3 HollandCoralena Company**FIRST REPORT** Contractor

C SL SW NW

SECTION PLAT

 Ft. from N. Line330 Ft. from S. Line Ft. from E. Line660 Ft. from W. Line

TRAPP POOL

Location Rig up

Drilling and Remarks:

10" - 200'Drlg. 250'

RECORD

Cased in., ft.Sand Gas Oil Total Depth

PRODUCTION

1st 24 hrs. Nat. 1st 24 hrs. after shot Gas Cu. Ft.Dry Hole Abandoned

Date

NOV 1 9 1941 19S. J. LEWIS Scout

Russell

KANSAS

Map No. 73 Sec. 16 Twp. 15 R. 13WWell No. 3 HollandCoralena CompanyCOMPLETED Contractor

C SL SW NW

SECTION PLAT

 Ft. from N. Line330 Ft. from S. Line Ft. from E. Line660 Ft. from W. Line

TRAPP POOL

RECORD

Location Cased in., ft.Rig up Sand

Drilling and Remarks:

Gas Oil Total Depth 3121

PRODUCTION

1st 24 hrs. Nat. 1st 24 hrs. after shot Gas Cu. Ft.Dry-Hole Abandoned

Date

DEC 23 1941 19S. J. LEWIS Scout

Leans 3097
5" @ 3091
4000 acid
Pump. 58 B.Y.

39° 42'

O.W.W.O.

FORM 513 SUNRAY

County Russell Elev. 1868
 Sec. 16 Twp. 15 Rge. 1 3W
 Company G R A
 Farm Name Holland No. 3

TOPS	DEPTH	LOG	DATUM	Loc. in Sec.
Anh.				G 5 ¹ / ₂ SW NW
TP.				
H.				<u>O.W.W.O.</u>
Tr.				
Dg.				
Bl.				
L.				Geol. _____
K.C.	3037			Contr. _____
B.K.C.				
Ce.				
C.				
M.				
M.				Pool _____
K.				
Mz.				
Ma.				
V.				
S.				
S.				FIRST REPORT
A.				0
R.				JAN 23 57
PE.				
G.				COMPLETE
T.D.				

Date Comm. OTD 3121 5" @ 3091 CO 3121
51/ 3061-82 1000 A 2000 A
Comp. 4.12 bopd 1.06 bw

15

Co.

Lse.

No.

Sec.

T.

R.