

KANSAS



WELL COMPLETION REPORT AND DRILLER'S LOG

API No. 15 — 035 — 21,838  
County Number

S. 36 T. 32 R. 4 E  
Loc. App. C SE NW  
County Cowley

Operator  
**TOMCO OIL**

Address  
**Rt. 1 Box 137A, Atlanta, Ks. 67008**


Well No. **1** Lease Name **EVANS**

Footage Location  
**600** feet from (S) line **300** feet from (E) line

Principal Contractor **White and Ellis Drilling** Geologist **G.R. McNeish**

Spud Date **5/5/81** Date Completed **6/13/81** Total Depth **2405' KB** P.B.T.D.

Directional Deviation **1°** Oil and/or Gas Purchaser **TOTAL PETROLEUM**

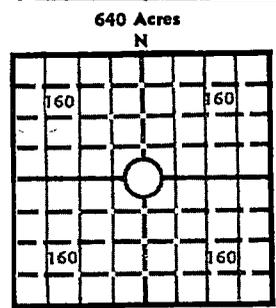

640 Acres  
Locate well correctly  
Elev.: Gr. **1261**  
DF \_\_\_\_\_ KB **1266**

CASING RECORD

Report of all strings set — surface, intermediate, production, etc.

Purpose of string	Size hole drilled	Size casing set (in O.D.)	Weight lbs/ft.	Setting depth	Type cement	Sacks	Type and percent additives
Surface	11"	8 5/8	27lb.	215'	common		
Prod.	7 7/8"	5 1/2	15	2401	common	185	2%gel, 1%chloride 6%gilsonite

LINER RECORD

PERFORATION RECORD

Top, ft.	Bottom, ft.	Sacks cement	Shots per ft.	Size & type	Depth interval

Size	Setting depth	Packer set at

ACID, FRACTURE, SHOT, CEMENT SQUEEZE RECORD

Amount and kind of material used	Depth interval treated

INITIAL PRODUCTION

Date of first production \_\_\_\_\_ Producing method (flowing, pumping, gas lift, etc.) \_\_\_\_\_

RATE OF PRODUCTION PER 24 HOURS	Oil	Gas	Water	Gas-oil ratio
	bbis.	MCF	bbis.	CFPB

Disposition of gas (vented, used on lease or sold) \_\_\_\_\_ Producing interval (s) \_\_\_\_\_

INSTRUCTIONS: As provided in KCC Rule 82-2-125, within 90 days after completion of a well, one completed copy of this Drillers Log shall be transmitted to the State Geological Survey of Kansas, 4150 Monroe Street, Wichita, Kansas 67209. Copies of this form are available from the Conservation Division, State Corporation Commission, 245 No. Water, Wichita, Kansas 67202. Phone AC 316-522-2206. If confidential custody is desired, please note Rule 82-2-125. Drillers Logs will be on an open file in the Oil and Gas Division, State Geological Survey of Kansas, Lawrence, Kansas 66044.

Operator

TOMCO OIL

DESIGNATE TYPE OF COMP.: OIL, GAS, DRY HOLE, SWDW, ETC.:

oil

Well No.

1

Lease Name

Evans

S 36 T 32 R 4 E

WELL LOG

Show all important zones of porosity and contents thereof; cored intervals, and all drill-stem tests, including depth interval tested, cushion used, time tool open, flowing and shut-in pressures, and recoveries.

SHOW GEOLOGICAL MARKERS, LOGS RUN, OR OTHER DESCRIPTIVE INFORMATION.

FORMATION DESCRIPTION, CONTENTS, ETC.

TOP

BOTTOM

NAME

DEPTH

Howard	1109			
Topeka	1251			
Peacock	1459			
Lower Peacock	1502			
Hoover Lime	1722			
Hoover Sand	1740			
Lower Hoover Sand	1829			
Iatan	1940			
Stalnaker	1973			
Lansing	2161			
Perry	2170			
Layton	2400			
TD	2405			

USE ADDITIONAL SHEETS, IF NECESSARY, TO COMPLETE WELL RECORD.

Date Received

Signature

Owner

Title

7/17/81

Date



OPERATOR: Tomco Oil Co. Rte. #1 Box 137-A Atlanta, Ks. 67008

CONTRACTOR: White & Ellis Drilling, Inc., Box 448, El Dorado, Kansas 67042

Lease Name Evans Well No. #1

Sec. 36 T. 32S R. 4E Spot NE NE SW

County Cowley State Kansas Elevation \_\_\_\_\_

Casing Record:

Surface: 8 5/8 @ 207' with \_\_\_\_\_ Sxs.

Production: \_\_\_\_\_ @ \_\_\_\_\_ with \_\_\_\_\_ Sxs.

Type Well: Oil Total Depth 2405'

Drilling Commenced: 6-9-81 Drilling Completed 6-13-81

Formation	From	To	Tops
Cellar	0	7	
Lime, Shale	7	590	
Shale, Lime	590	1254	
Lime, Shale	1254	1410	
Shale, Lime	1410	1803	
Lime, Shale, Sand	1803	1980	
Lime, Shale	1980	2301	
Shale, Lime	2301	2405	

COMPLETION RECORD

Liner Record: Size \_\_\_\_\_ From \_\_\_\_\_ To \_\_\_\_\_

Cementing Record: \_\_\_\_\_ Sacks \_\_\_\_\_

Perforating Record: