


Section 27 Township 12 Range 16 W

Well No. # 5 Froelich (E)

Company Kewanee Oil

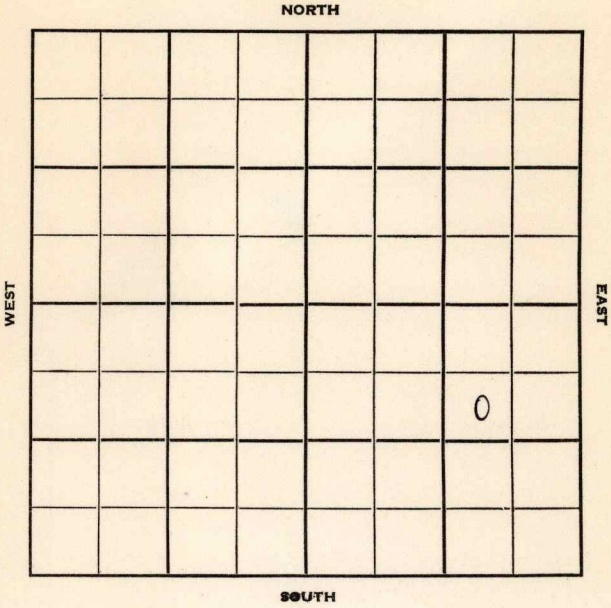

Ellis

KANSAS

Sec. 27 Twp. 12 R. 16W

Well No. #5 Froelich (E) Farm

Kewanee Oil Company

Gross Contractor

Emmerman


990 Ft. from N. Line

_____ Ft. from S. Line

990 Ft. from E. Line

_____ Ft. from W. Line

SW NE SE

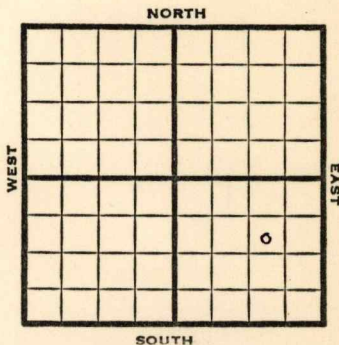

1951

Elev. 2008' REPORT

10/31
12/19

8" @ 241' WOC
 Oil Well TD 3476
 8" @ 241
 Anhy 1132 Heeb. 3157
 Dodge 3182 Lans. 3209
 Arb. 3468
 TD 3471 7" @ 3467 DD 3476
 S/ 69 BO 6 hr. S/ 17 BO 1 hr.
 Comp. 240 BOPD

COMPLETED

