


Section 27 Township 12 Range 16W

Well No. #6 Froelich "E"

Company Kewanee Oil

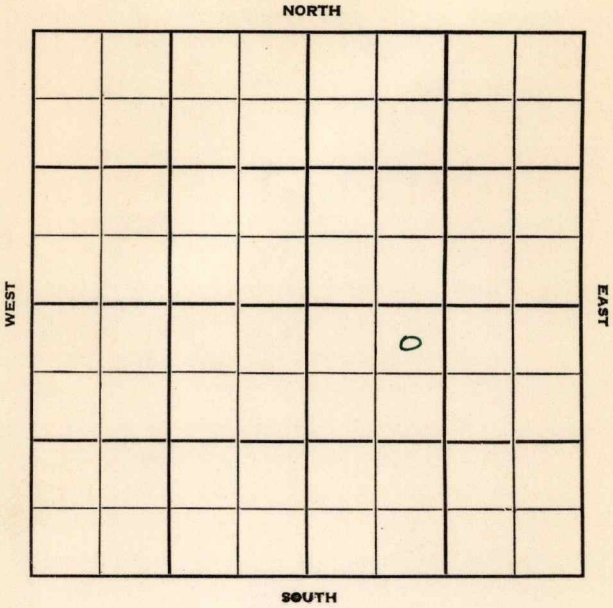

Ellis

KANSAS

Sec. 27 Twp. 12 R. 16W

Well No. #6 Froelich (E) Farm

Kewanee Oil Company


Gross - Contr. Contractor

330' Ft. from N. Line

..... Ft. from S. Line

..... Ft. from E. Line

990' Ft. from W. Line

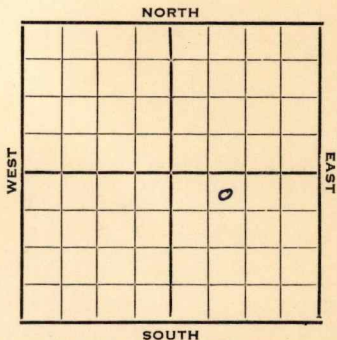

NE NW SE

1951 Elev. 1998' REPORT

11/28 Location

1952

1/16

Spud 12-3-51
Oil Well TD 3479

10" @ 230

Heeb. 3154

Tor. 3176

Lans. 3204

Arb. 3471-75

7" @ 3472'

TD 3479 S/ 6 BOPH Comp. 140 BOPD

COMPLETED

County Ellis State Kansas

Sec. 27 (Blk. 12) (Sur. 16W) (Twp.) (Rge.) Map No.

Operator Kewanee Oil

Well No. 6 Farm Froelich "E"

Elev. 1998 Location NE NW SE

COMPLETE

330 Ft. From N Line SE

990 Ft. From W Line Quarter

Ist. Report

Completion JAN 16 1952

Remarks

Gross - Contr.

Spudding Date 12-3-51

Drlg. Data Oil well TD 3479

10" @ 230 Heeb. 3154 Tor. 3176

Lans. 3204 Arb. 3471-75 7" @ 3472

TD 3479 S/ 6 boph Comp. 140 bopd

J. E. TYRA