


Section 16 Township 15 Range 13W

Well No. #7 Holland

Company Coralena

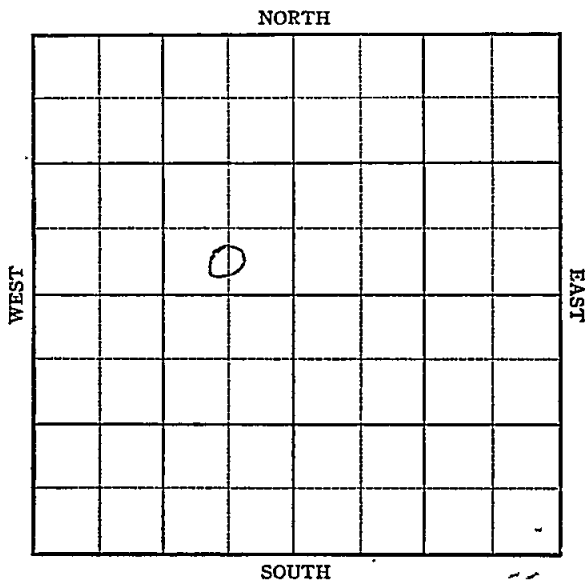

KANSAS

Russell County

Sec. 16 Twp. 15 R. 13W

Well No. #7 Holland Farm

Coralena Company

Trapp


 Ft. from N. Line

330 Ft. from S. Line

660 Ft. from E. Line

 Ft. from W. Line

CSL SE NW

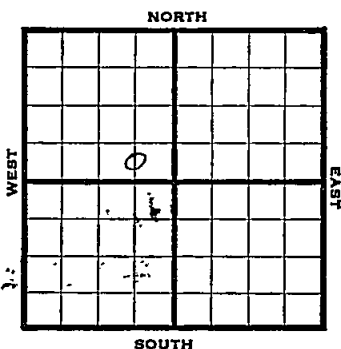

1946 1866 REPORT

7/24 RUR .
7/30 8" @ 490'
Anhy 828,
Drlg 1840'
8/6 Topeka 2740
Lans 3035
Drlg 3255'
8/13 Arb 3318-
3333 TD
5" @ 3318-2200' oil 2 hrs
8/20 " " "
8/28 Arb 3318'
5" @ 3318'
TD 3333'
Pump 85 Pot
40.7 Grav.

COMPLETED

KANSAS

Kansas Pool Name TrappMap No. 73 Sec. 16 Twp. 15 R. 13WWell No. 7 HollandCoralena


Company

FIRST REPORT

Contractor

C S L SE NW

SECTION PLAT

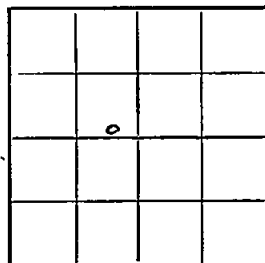 Ft. from N. Line330 Ft. from S. Line660 Ft. from E. Line Ft. from W. LineRussell CountyLocation Rig up

Drilling and Remarks:

R U R

RECORD

Cased in., ft.Sand Gas Oil Total Depth

PRODUCTION

1st 24 hrs. Nat. 1st 24 hrs. after shot Gas Cu. Ft.Dry Hole Abandoned

Date

JUL 24 1946 19S. J. LEWIS Scout

KANSAS

Pool Name Trapp Pool

Kansas

Map No. 73 Sec. 16 Twp. 15 R. 13WWell No. 7 HollandCoralena Company

COMPLETED

Contractor

C S L SE NW

E 11866

SECTION PLAT

Ft. from N. Line

330 Ft. from S. Line660 Ft. from E. Line

Ft. from W. Line

Russell County

Location

Rig up

Drilling and Remarks:

*Cr 73318.**5" @ 3318.**Pump 80 P.S.**402 8/2*

RECORD

Cased in. ft.Sand Gas Oil Total Depth 2223

PRODUCTION

1st 24 hrs. Nat. 1st 24 hrs. after shot Gas Cu. Ft.Dry Hole Abandoned

Date

AUG 28 1946 19 S. J. LEWIS Scout