


Section 27 Township 12 Range 16W

Well No. 9 Froelich "E"

Company Kewanee Oil

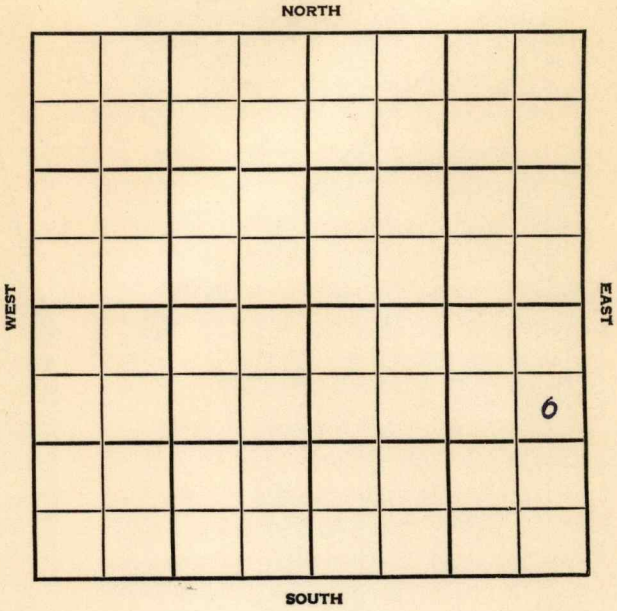

SEC.	TWP.	R.
27	12	16W


WELL NO. #9 Froelich "E" FARM

COMPANY Kewanee Oil

CONTRACTOR Lewis

Emeran Pool

990 Ft. from N. Line
 _____ Ft. from S. Line
 330 Ft. from E. Line
 _____ Ft. from W. Line

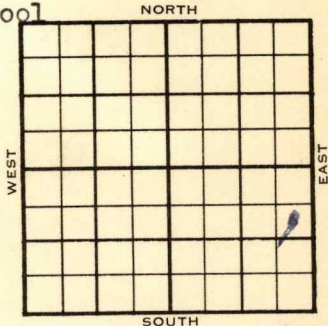

SE NE SE

1955	ELEVATION 2001'	REPORT
------	--------------------	--------

3/9

R U R

4/20

Spud 3-10-55
 Oil Well
 TD 3465'
 Heeb. 3147', Dodge. 3171' KC 3198'
 DST 3258'-3305' opn 1 hr, rec 2435'
 gas, 365' vho & gcm 790# Arb. 3459'
 TD 3463'
 7" @ 3460'
 CO to 3462'
 DD 3465'
 S/ 62.63 bo 26.92 bw 19 hr.
 SP 3410' 20/ 3268-73 20/ 3273-78
 12/ 3289-92 B/ 1/2 go 13 gw 3 hr.
 1500 A S/ 482 bo 23 hr. S/ 21 boph
 P/ 110 bo 15 hr.
 Comp 108 bopd. 9 bw.

COMPLETED

