

KANSAS


Barton County

FORM 51 5M 11-44 PETROL

Section 25 Township 16S Range 12W

Well No. #2 Oser "B"

Company D. J. Marshall

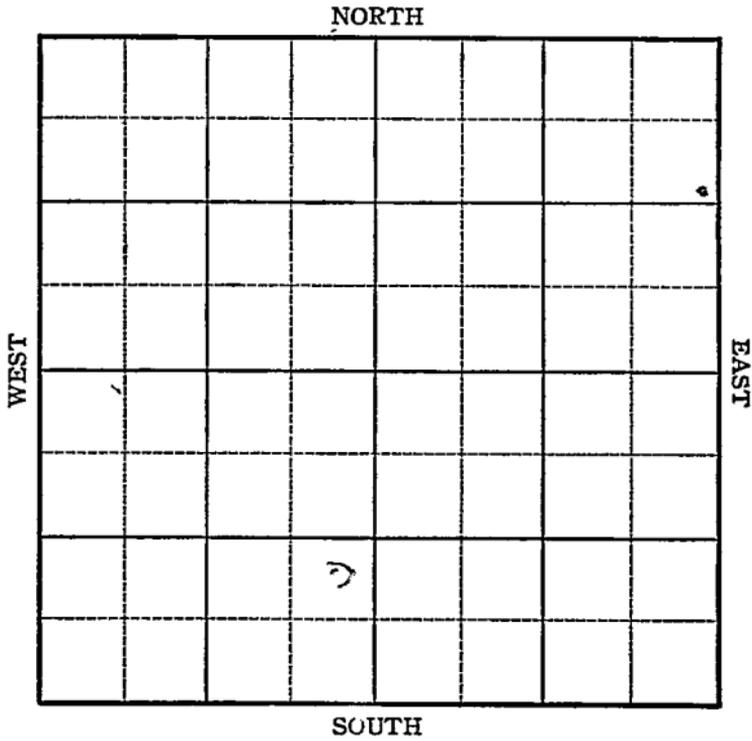

KANSAS Barton County


Sec. 25 Twp. 16 R. 12W

Well No. #2 Oser "B" Farm

D. J. Marshall Company

Kraft-Prusa

_____ Ft. from N. Line
990 Ft. from S. Line
330 Ft. from E. Line
_____ Ft. from W. Line

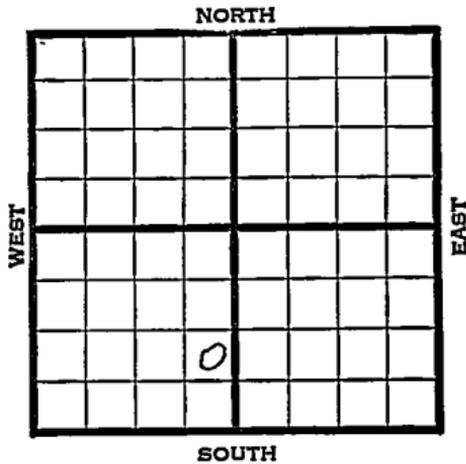

NE SE SW

1945	Elev. 1932	REPORT
3/21		Drlg. 300'
3/29		8" @ 300
		Drlg. 2400'
4/5		Topeka 2726
		Lans 3092
		Gorham 3316-3318
		TD 3333
		5" @ 3316' RUST
4/12		" " " " "
4/20		TD 3334'
		1500' oil 12 hrs.
4/27		TD 3337'
		200' oil 1 hr.
5/3		" " " "
5/10		" " " "
5/17		Pump 60 oil a day. 60% wtr.
5/24		" " " " " "
5/31		" " " " " "
6/8		" " " " " "
6/14		" " " " " "
6/21		" " " " " "
7/3		Gorham 3316
		5" @ 3316
		3000 acid.
		TD 3337'
		Pump 108 Pot.
		Grav. 42.4

COMPLETED

