

KANSAS

FORM 51 5M 10-41 PETROL


Section 25 Township 16 Range 12-W

Well No. #2 Reimann

Company Black-Marshall

Beaver Pool

NORTH

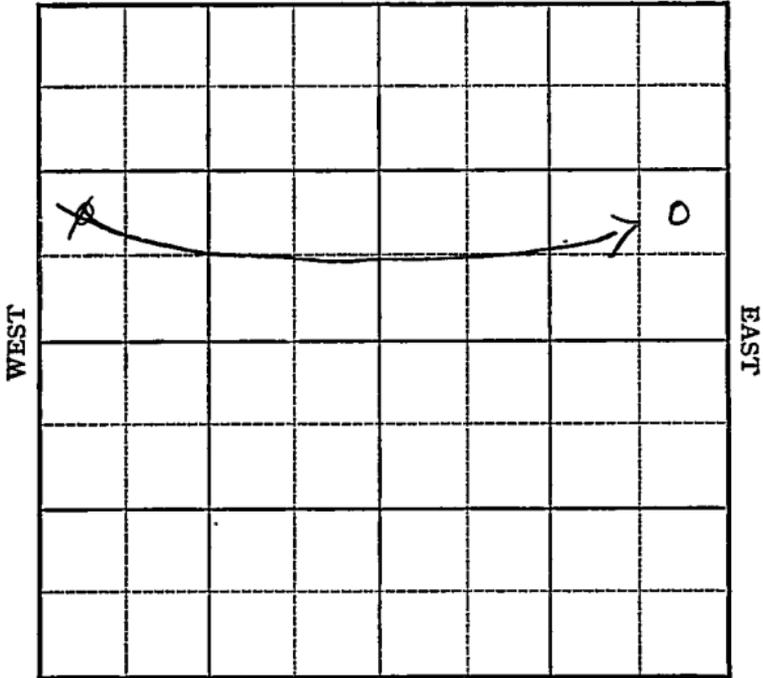

SOUTH

Sec. 25 Twp. 16 R. 12-W

Well No. #2 Reimann Farm

Black-Marshall Company

(Beaver Pool)


 Ft. from N. Line

990 Ft. from S. Line

330 Ft. from E. Line

500 Ft. from W. Line

Elev. 1933

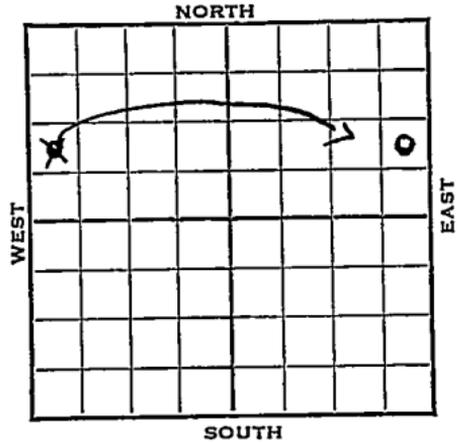

1942

REPORT

7/22	Rotary
7/29	Spud
8/5	12" - 470 Drlg. 575'
8/12	Anhy 768, 10" @ 773 Drlg 1525
8/19	Drlg. 2295 8" - 2140'
8/27	8" @ 2448 Topoka 2745 Drlg 2790
9/2	Lans. 3091 SO 7" - 3094 T.D. 3296 U R 7"
9/9	Cong 3325 TD 3328 5" @ 3326 WOC
9/16	2100 acid swb 22 oil in 24 hrs.
9/23	Cong. 3325 5" 3326 TD 3328 2100 acid Pump 449 Pot. 39 Gr.

COMPLETED

KANSAS

Barton

Map No. 55 Sec. 25 Twp. 16 R. 12W

Well No. 2 Reimann

Black-Marshall Company

FIRST REPORT Contractor

NW SW NW

SECTION PLAT

_____ Ft. from N. Line

990 Ft. from S. Line

_____ Ft. from E. Line

330 Ft. from W. Line

o			

BEAVER POOL

RECORD

Location _____

Cased _____ in., _____ ft.

Rig up _____

Sand _____

Drilling and Remarks:

Gas _____

Oil _____

Total Depth _____

Rotary

PRODUCTION

1st 24 hrs. Nat. _____

1st 24 hrs. after shot _____

Gas _____ Cu. Ft.

Dry Hole _____

Abandoned _____

Date

JUL 22 1942 19

S. J. LEWIS Scout

Barton

KANSAS

Map No. 55 Sec. 25 Twp. 16 R. 12W

Well No. 2 Reimann

Black-Marshall

Company

CORRECTION

Contractor

NE SE NE

SECTION PLAT

			o

_____ Ft. from N. Line

990 Ft. from S. Line

330 Ft. from E. Line

_____ Ft. from W. Line

BEAVER POOL

Location _____

Rig up _____

Drilling and Remarks:

Reported

NW SW NW

RECORD

Cased _____ in., _____ ft.

Sand _____

Gas _____

Oil _____

Total Depth _____

PRODUCTION

1st 24 hrs. Nat. _____

1st 24 hrs. after shot _____

Gas _____ Cu. Ft.

Dry Hole _____

Abandoned _____

Date

JUL 29 1942

19

S. J. LEWIS

Scout

