

KANSAS


Form 51-5M-7-39-Palace

Russell

Section 17 Township 15 Range 13-W

Well No. #2 T. Sellens

Company Coralena ~~Pco~~

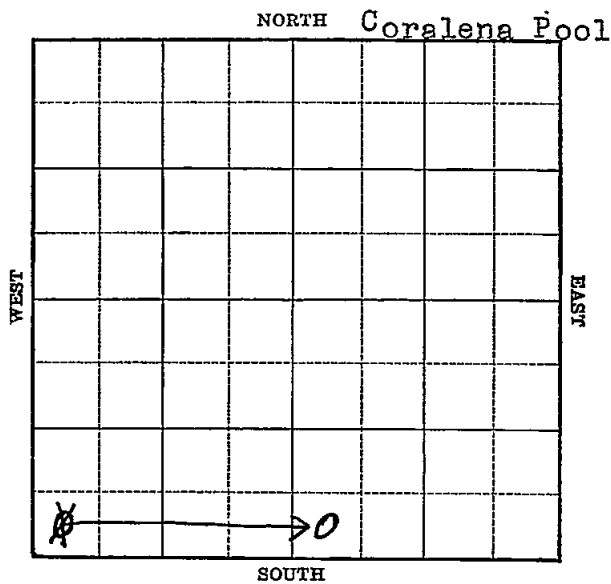

Russell

KANSAS

Map No. 73 Sec. 17 Twp. 15 R. 13WWell No. 2 T. SellensCoralena pool

Company

Contractor

FIRST REPORT
SW/C

SECTION PLAT

 Ft. from N. Line330 Ft. from S. Line Ft. from E. Line330 Ft. from W. Line

CORALENA POOL

Location XRig up

Drilling and Remarks:

RECORD

Cased in., ft.Sand Gas Oil Total Depth

PRODUCTION

1st 24 hrs. Nat. 1st 24 hrs. after shot Gas Cu. Ft.Dry Hole Abandoned

Date

OCT 18 1939

Scout

Russell

KANSAS

Map No. _____ Sec. 17 Twp. 15 R. 13WWell No. 2 T. SellensCoralena

Company

CORRECTION

Contractor

SECTION PLAT

SW SE

_____ Ft. from N. Line

330

_____ Ft. from S. Line

_____ Ft. from E. Line

330

_____ Ft. from W. Line

CORALENA POOL

Location _____

Rig up _____

Drilling and Remarks:

Reported: A

SW/C

RECORD

Cased _____ in., _____ ft.

Sand _____

Gas _____

Oil _____

Total Depth _____

PRODUCTION

1st 24 hrs. Nat. _____

1st 24 hrs. after shot _____

Gas _____ Cu. Ft.

Dry Hole _____

Abandoned _____

Date

193 1 11 S

Scout

Russell

KANSAS

Map No. 73 Sec. 17 Twp. 15 R. 13WWell No. 2 T. SellensCoralena

Company

Contractor

COMPLETED

SW SE

 Ft. from N. Line330 Ft. from S. Line Ft. from E. Line330 Ft. from W. Line

SECTION PLAT

CORALENA POOL

Location Rig up

Drilling and Remarks:

*Oil 8.3333**7" @ 3334**Pump 153 1/2*

RECORD

Cased in., ft.Sand Gas Oil Total Depth 8345

PRODUCTION

1st 24 hrs. Nat. 1st 24 hrs. after shot Gas Cu. Ft.Dry Hole Abandoned

Date

DEC 6 1938

S. J. LEWIS

Scout