


SECTION 17 TOWNSHIP 15S RANGE 13WWELL NO. B-1
#13-L. SellensCOMPANY CRA, Kepler & Boone

NORTH

N/2 NW NW

WEST

EAST

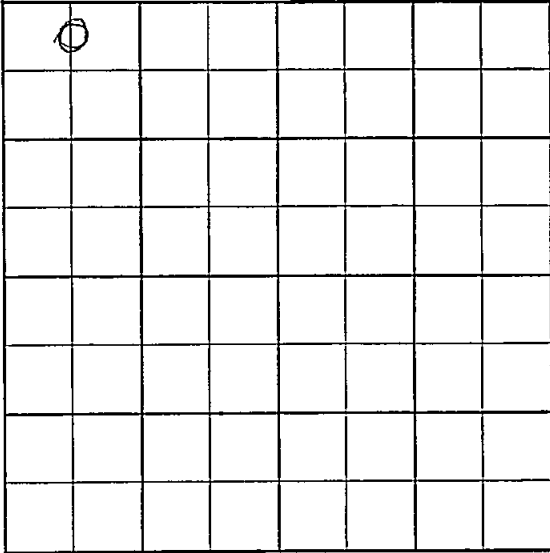

SOUTH

~~Private Property~~
~~Do Not Enter~~


County Russell Elev. _____
 Sec. 17 Twp. 15 Rge. 1 3W
 Company CRA, Kepler & Boone
 Farm Name L. Sellens No. 13

TOPS	DEPTH	LOG	DATUM
Anh.			
Tp.			
H.			
Tr.			
Dg.			
B.L.			
L.			
K.C.			
B.K.C.			
Ce.			
C.			
M.			
M.			
K.			
Mz.			
Mq.			
V.			
S.			
S.			
A.			
R.			
Pf.			
G.			
T.D.			

Loc. in Sec. N/2 NW NW

Geol. _____
 Contr. _____
Shields

Pool _____
Trapp

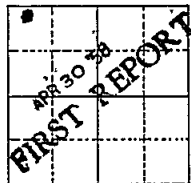

Date Comm. _____

Location

Co.

Lse.

No.

Sec.

T.

R.

Pool

Co.

Facet

Elev 17580: 17614A

Rge. 13W

Form Name L. Sellens

No B-155

TOPS:	DEPTH	LOG	DATUM:
Anh Tankin	2345		
Tr.			
Dg.			
B.L.			
L.	2914		
K.C.			
B.K.C.			
Ce.			
C.			
M.			
M.			
K.			
Mz.			
Mq.			
V.			
S.			
S.			
A.	3181		
R.			
Pf.			
G.			
T.D.	3184		

Loc. in Sec. _____
N/2 NW NW

Geol. _____

Contr. _____
Shields

Pool _____
Trapp _____

COMPLETE

JUN 11 1958

Date Comm. 5-4-58

Location MAY 7 '58 MAY 14 '58 S 7 47 / 42

Cal 2293-2809 (5 ch) 30

cid 2944 NW 21 St -52 Cid 2944

2985-3110 5" 3/8 3/175 mict

MAY 28 58 CO 3189 DD3189 TD FU

3 50' W / 650' N NT PB 3140 8 / 3068-70

24/3086-92 16/3102-86 (2) 5/180 18W


Thrs 80/300-27 (2) 5 ana 5 Boph 3B

WPH NT 887132 49B41 12 hrs CO
3140 PDB P45B0 1313W 19 hrs

3140 ~~POB~~ P45 BD 1313W-19Ans

FORM 513-1 SUNRAY

P 70.50.30 4.20 BW JUN 11 5
P 5830 NW 294-3

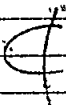

17-15-13W

N/2 NW NW