


KANSAS

Barton county

Section 25 Township 16 Range 12W

Well No. #7, Rieman

Company Balck-Marshall

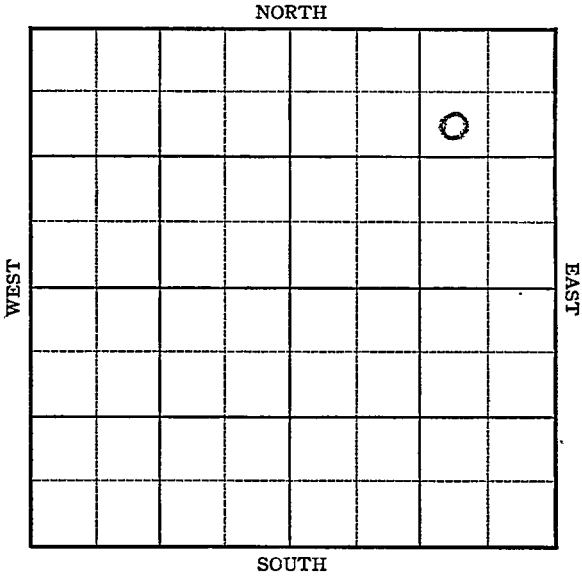

KANSAS

Barton County


Sec. 25 Twp. 16 R. 12WWell No. #7 Rieman FarmBlack-Marshall

Company

Kraft-Prusa

990 Ft. from N. Line Ft. from S. Line990 Ft. from E. Line Ft. from W. Line

SW NE NE

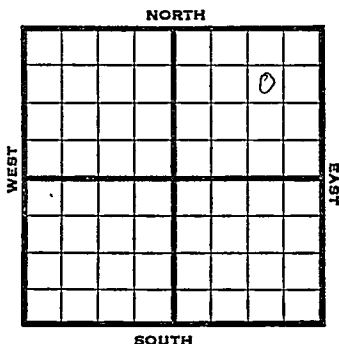

1946	Elev 1930' REPORT
3/27	Location
4/4	RUR
4/10	12" @ 480, 10" @ 777 Drlg 875
4/16	Drlg 2050
4/23	8" @ 2451 Drlg 2560'
5/1	7" @ 3047 Drlg 3180
5/7	Basal sd 3334-39 TD 5" @ 3331 RUST
5/14	TD 3344 Pump 10 oil PH
5/21	" " "
5/29	" " "
6/5	" " "
6/12	Basal Sd 3334 5" @ 3331' Pump 17 oil plus 17 W Pot 42.0 Gr TD 3344'

COMPLETED

KANSASKansas Pool Name Kraft-PrusaMap No. 55 Sec. 25 Twp. 16 R. 12WWell No. 7 RiemanBlack-Marshall

Company

FIRST REPORT

Contractor

SW NE NE

SECTION PLAT990

Ft. from N. Line

Ft. from S. Line

990

Ft. from E. Line

Ft. from W. Line

			o

Barton CountyLocation X

Rig up

Drilling and Remarks:

RECORDCased in., ft.

Sand

Gas

Oil

Total Depth

PRODUCTION.

1st 24 hrs. Nat.

1st 24 hrs. after shot

Gas Cu. Ft.

Dry Hole

Abandoned

Date

MAR 27 1946

19

S. J. LEWIS

Scout

KANSAS

Kansas

Pool Name Kraft-PrusaMap No. 55 Sec. 25 Twp. 16 R. 12WWell No. 7 RiemanBlack-Marshall

Company

COMPLETED

Contractor

SW NE NE

E 1/80
SECTION FLAT990 Ft. from N. Line

Ft. from S. Line

990 Ft. from E. Line

Ft. from W. Line

			0

Barton County

Location

Rig up

Drilling and Remarks:

Basal Sol 3334
5" @ 333'Pump 17 oil + 17W
Bo 842 @ 8W**RECORD**

Cased _____ in., _____ ft.

Sand _____

Gas _____

Oil _____

Total Depth 3344**PRODUCTION**

1st 24 hrs. Nat. _____

1st 24 hrs. after shot _____

Gas _____ Cu. Ft.

Dry Hole _____

Abandoned _____

Date

JUN '12 1946 19S. J. LEWIS

Scout