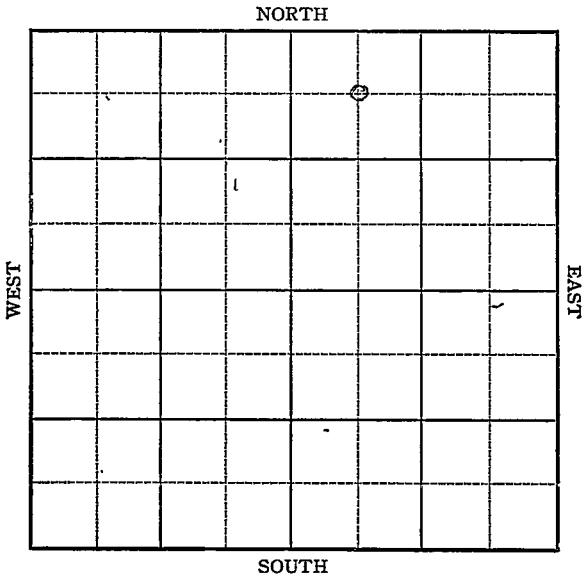
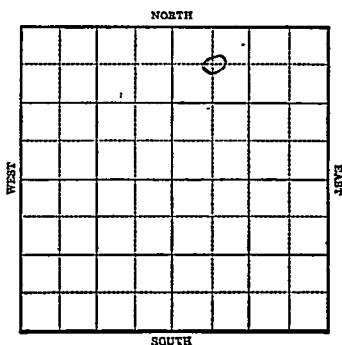


Section 25 Township 16 Range 12 W.Well No. #3 RiemannCompany Black & Marshall

Sec. 25 Twp. 16 R. 12-WWell No. #3 Riemann FarmBlack & Marshall Company660 Ft. from N. Line Ft. from S. Line Ft. from E. Line660 Ft. from W. LineElev. 1910

1943

R E P O R T

12/1	Derrick		
12-15	Cable Rig		
12/22	Spud 95'		
12/29	No report		
1944			
1-5	12" @ 455	10" @ 766	
	Drlg 1105'		
1-12	Drlg 2112'		
1/19	2488' HR 8"		
1/26	8" @ 2448		
	Topeka 2670		
	Drlg. 2965'		
2/2	Lans 3068		
	SO 3225-30		
	Cong 3295		
	Basal Sd 3321		
	TD 3324 HFO		
	Run 5"		
2/8	5"@ 3320		
	TD 3330		
	Pump 10 oil per hr 6 hrs.		
2/15	"	"	"
2/23	"	"	"
3/1	"	"	"
3/8	"	"	"

OVER

1944

3/16 5" @ 3320
TD 3330

3/22 Basal 3320
5" @ 3320
TD 3330
Pump 295 Pot
Gravity 3910

COMPLETED

KANSASMap No. 55 Sec. 25 Twp. 16 R. 12WWell No. 3 RiemannBlack & Marshall CompanyFIRST REPORT Contractor**C NW NE****SECTION PLAT**660 Ft. from N. Line Ft. from S. Line Ft. from E. Line660 Ft. from W. Line

		o	

Beaver PoolLocation Rig up

Drilling and Remarks:

Derrick**RECORD**Cased in., ft.Sand Gas Oil Total Depth **PRODUCTION**1st 24 hrs. Nat. 1st 24 hrs. after shot Gas Cu. Ft.Dry Hole Abandoned

Date

DEC 1 1943 19S. J. LEWIS Scout

KANSAS

Map No. 55 Sec. 25 Twp. 16 R. 12 WWell No. 3 RiemannBlack-Marshall

Company

COMPLETED

Contractor

C NW NE

SECTION PLAT

660 Ft. from N. Line

Ft. from S. Line

Ft. from E. Line

660 Ft. from W. Line

		0	

Beaver Pool

Location

Rig up

Drilling and Remarks:

*Basel Sol 320**5' 0320**Pump 295 28**89 2 84*

RECORD

Cased _____ in., _____ ft.

Sand _____

Gas _____

Oil _____

Total Depth 3320

PRODUCTION

1st 24 hrs. Nat. _____

1st 24 hrs. after shot _____

Gas _____ Cu. Ft.

Dry Hole _____

Abandoned _____

Date

MAR 22 1944 19

S. J. LEWIS

Scout