


Section 17 Township 15 Range 13-W

Well No. #9 L. sellens

Company Coralena

NORTH Coralena Pool

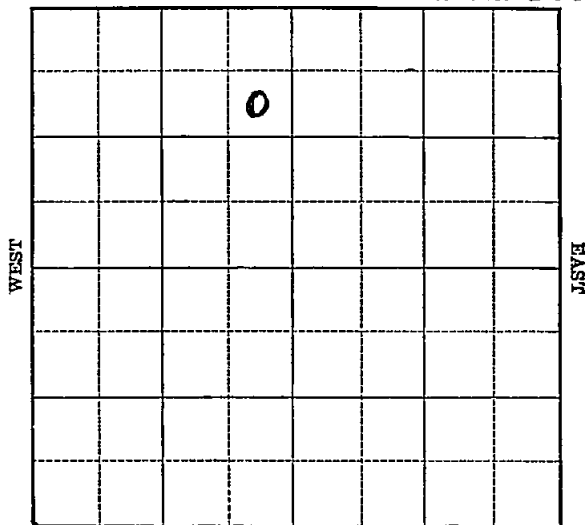

SOUTH

Sec. 17 Twp. 15 R. 13-W

Well No. #9 L. Sellens Farm \_\_\_\_\_

Coralena Company \_\_\_\_\_

(Coralena)


990 Ft. from N. Line

\_\_\_\_\_ Ft. from S. Line

330 Ft. from E. Line

\_\_\_\_\_ Ft. from W. Line

Elev. 1777

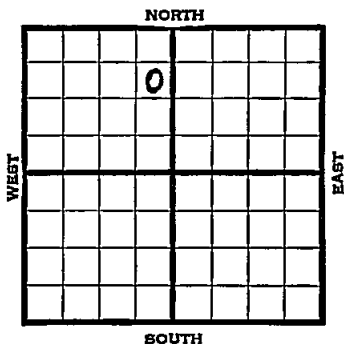

1939	REPORT
8/9	10" - 234' Drlg. 1705'
8/17	Arb. 3193' 7" - 3193' T.D. 3200' RUST.
8/24	" " " "
8/31	Shut down.
9/7	" "
9/13	Arb. 3193'
	7" - 3193'
	T.D. 3200'
	Echometer potential 4755 bbls.
	Maximum 2500 bbls.
	<b>COMPLETED</b>

Map No. 73 Sec. 17 Twp. 15 R. 13W

Well No. 9 L. Sellens

Coralena Company

Contractor

**FIRST REPORT**

**SECTION PLAT**

**SE NE NW**  
990 Ft. from N. Line  
 \_\_\_\_\_ Ft. from S. Line  
330 Ft. from E. Line  
 \_\_\_\_\_ Ft. from W. Line

	o		

**CORALENA POOL**

Location \_\_\_\_\_

Rig up \_\_\_\_\_

Drilling and Remarks:

10" - 234

Dr1g. 1705

**RECORD**

Cased \_\_\_\_\_ in., \_\_\_\_\_ ft.

Sand \_\_\_\_\_

Gas \_\_\_\_\_

Oil \_\_\_\_\_

Total Depth \_\_\_\_\_

**PRODUCTION**

1st 24 hrs. Nat. \_\_\_\_\_

1st 24 hrs. after shot \_\_\_\_\_

Gas \_\_\_\_\_ Cu. Ft.

Dry Hole \_\_\_\_\_

Abandoned \_\_\_\_\_

Date

13

19

Scout

Map No. \_\_\_\_\_ Sec. 17 Twp. 15 R. 13W

Well No. 9 L. Sellens

Coralena Oil Company

Contractor

**COMPLETED**

SE NE NW

990 Ft. from N. Line

\_\_\_\_\_ Ft. from S. Line

330 Ft. from E. Line

\_\_\_\_\_ Ft. from W. Line

CORALENA POOL

**SECTION PLAT**

	o		

Location \_\_\_\_\_

Rig up \_\_\_\_\_

Drilling and Remarks:

*Q 83193*  
*7" @ 3193*  
*Eckornotes P & J*  
*H 755*  
*Maximum*  
*2500*

**RECORD**

Cased \_\_\_\_\_ in., \_\_\_\_\_ ft.

Sand \_\_\_\_\_

Gas \_\_\_\_\_

Oil \_\_\_\_\_

Total Depth 3200

**PRODUCTION**

1st 24 hrs. Nat. \_\_\_\_\_

1st 24 hrs. after shot \_\_\_\_\_

Gas \_\_\_\_\_ Cu. Ft.

Dry Hole \_\_\_\_\_

Abandoned \_\_\_\_\_

Date

SEP 1, 1930 19

S J LEWIS Scout