


Section 17 Township 15 Range 13W

Well No. #12 Sellens

Company C R A

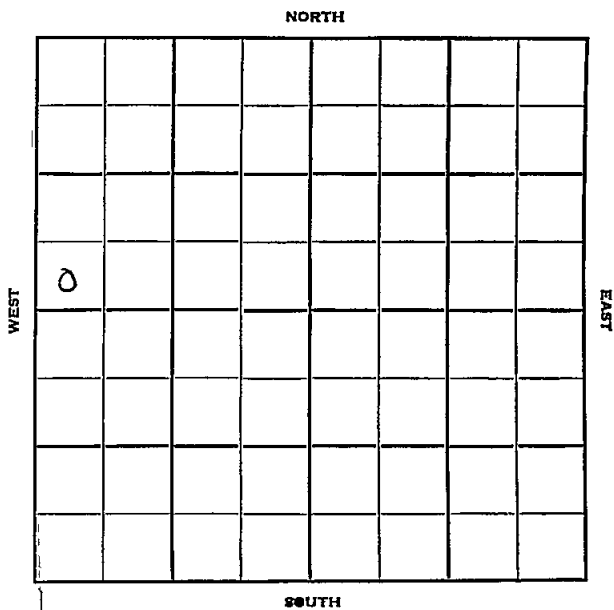

Sec. 17 Twp. 15 R. 13 W

Well No. # 12 Sellens Farm

C R A Company

C R A Contractor


Trapp Pool

Ft. from N. Line

330 Ft. from S. Line

Ft. from E. Line

330 Ft. from W. Line

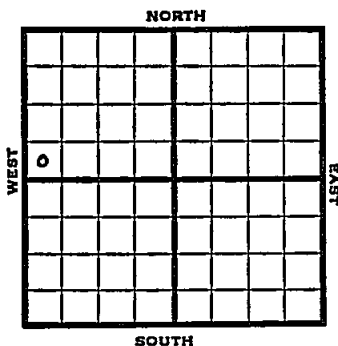

SW SW NW

1951 Elev. 1780' REPORT

2/7 Spud 2/5/51
8" @ 776'
WOC

3/21 Spud 2-5-51
Oil Well TD 3237
8" @ 776'
Heeb. 2900' Toronto 2917
Lans. 2967
DST 2985-3006 opn 1 hr
Rec. 30' ocm
Arb. 3233-37 5" @ 3234
TD 3237 S/23 bo 1 hr
Comp. 38 bo 165 bwpd

COMPLETED

County Russell State Kansas

Sec. 17 (Blk. Twp.) 15 (Sur. Rge.) 13W Map No.

Operator C R A

Well No. 12 Farm Sellens

Elev. _____ Location SW SW NW

0							
FIRST REPORT							

330 Ft. From S Line NW

330 Ft. From W Line Quarter

lst. Report FEB 7 1951

Completion _____

Remarks _____

C R A - Contr.

Spudding Date 2-5-51

Drlg. Data Trapp Pool

8" @ 776 WOC

J. E. TYRA

