


Section 2 Township 12 Range 17 W

Well No. # 1 Hall "B"

Company United Drlg. Co.

NORTH

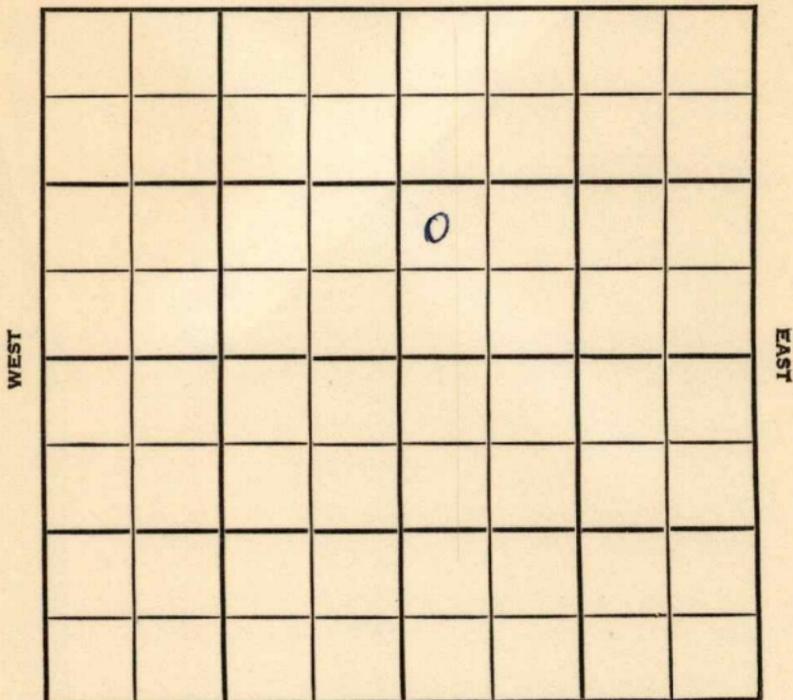

SOUTH





