

KANSAS

Russell


FORM 51 5M 4-41 PETROL

Section 17 Township 15 Range 13-W

Well No. #3 Sellens

Company Coralnea

NORTH Trapp Pool

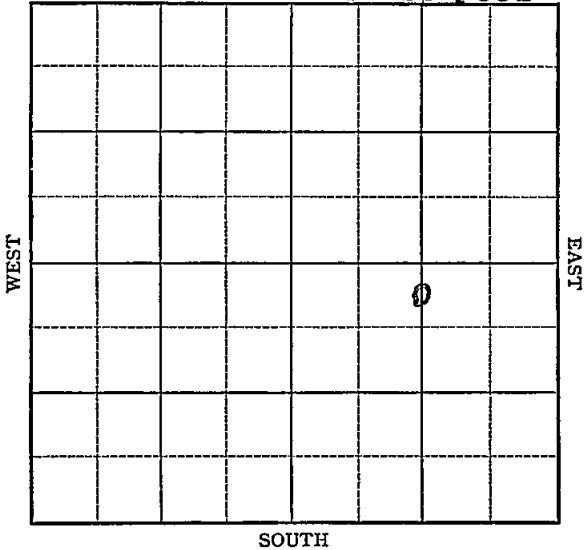

Map No. 73 Sec. 17 Twp. 15 R. 13WWell No. 3 SellensCoralena

Company

FIRST REPORT

Contractor

C NL SE

330 Ft. from N. Line

_____ Ft. from S. Line

1320 Ft. from E. Line

_____ Ft. from W. Line

SECTION PLAT

TRAP P POOL

Location _____

Rig up _____

Drilling and Remarks:

Derrick

RECORD

Cased _____ in., _____ ft.

Sand _____

Gas _____

Oil _____

Total-Depth _____

PRODUCTION

1st 24 hrs. Nat. _____

1st 24 hrs. after shot _____

Gas _____ Cu. Ft.

Dry Hole _____

Abandoned _____

Date

JUN 3 1942

19

S. J. LEWIS Scout

Russell

KANSAS

Map No. 73 Sec. 17 Twp. 15 R. 13W

Well No. 3 Sellen s

Coralena Company

COMPLETED

Contractor

C N L S E

330 Ft. from N. Line

_____ Ft. from S. Line

1320 Ft. from E. Line

_____ Ft. from W. Line

SECTION PLAT

		o	

TRAPP POOL

Location _____

Rig up _____

Drilling and Remarks:

Core 3232

5" @ 3233

Run 15 24

39 1/2

RECORD

Cased _____ in., _____ ft.

Sand _____

Gas _____

Oil _____

Total Depth 3253

PRODUCTION

1st 24 hrs. Nat. _____

1st 24 hrs. after shot _____

Gas _____ Cu. Ft.

Dry Hole _____

Abandoned _____

Date

JUL 8 1942 19

S. J. LEWIS Scout

O.W.W.O.

S-513-B

County Russell Elev. 1795 DF
 Sec. 17 Twp. 15S Rge. 13W
 Company C. R. A.
 Farm Name Tom Sellens No. 3

TOPS	DEPTH	LOG	DATUM
Anh.			
Tp.	2660		
H.			
Tr.			
Dg.	2926		
B.L.			
L. <u>-K?C</u>	2963		
K.C.			
B.K.C.			
Ce.			
C.			
M.			
M.			
K.			
Mz.			
Mq.			
V.			
S.			
S.			
A.	3232		
R.			
Pf.			
G.			
T.D.			

Loc. in Sec. N/2 N/2 SE
O.W.W.O.
O.W.W.O.

Geol. _____
 Contr. _____
 Pool Trapp

COMPLETE
FIRST REPORT

Date Comm. Old info - OTD 3253; 5" 3233;
Arb. well comp. 6-7-42.

New info - spud 7-1-58; CO 3253 OTD; GRN
log; 28/3153-60; plug @ 3176; 16/3154-60;
FU 65' WIH/1 hr; 2000 A; swb 60 bo / 110
bw 10 hrs.; 32/3062-70; plug @ 3100; 2000 A;
at 3062-70; CO 3176; PB TD; pwp; pmp 24 bo
/ 215 bw 24 hrs.; pmp 25 bo / 189 bwpd 30
days

Ø LK prod.