


Ellis

KANSAS

SECTION 2 TOWNSHIP 12 RANGE 17W

WELL NO. #2 Hall

COMPANY Mallonee Drlg.

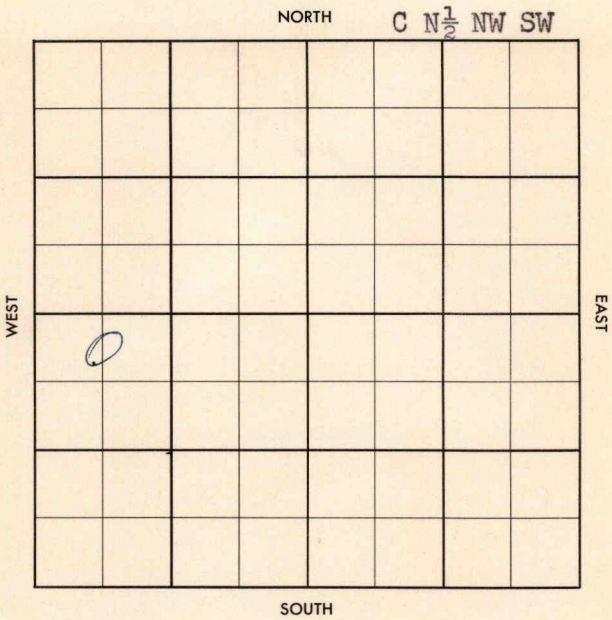

Date Comm.	5-20-57	Sec.
8" @ 200	WOC	

8" @ 200

WOC

Co.

Use

No.

Sec.

1

ス

County Ellis Elev. 2121
 Sec. 2 Twp. 12 Rge. 17W
 Company Mallonee Drlg.
 Farm Name Hall No. 2

TOPS	DEPTH	LOG	DATUM	Loc. in Sec.
Anh.	1308			C N $\frac{1}{2}$ NW SW
Tr.				
H.	3303			
Tr.	3327			
Dg.				
Bl.				
L.	3353			Geol.
K.C.				
B.K.C.				Contr.
Ce.				Co. tools
C.				Bemis-shutt's
M.				Pool
M.				Vye
K.				
Mz.				
Me.				
V.				
S.	3612			COMPLETE
S.	3618			
A.				
R.				
Pe.				
G.				
TD.	3623			JUL 24 '57

Date Comm. 5-20-57

8" @ 200 WOC MAY 29 '57 3210 JUN 5 '57

Anh. 1308 H6 3303 L59 3353 C9'

SP. H16 3618 DST 3618-23 hrs.

run 135' clean oil BHP 410/20"

no Log 5 1/2 @ 3622 JUN 12 '57 BACK

Tops Tr 3327 SP 3612 no C9

MICT CO 3623 7 Goph. no/w

no time PD 3629' PTD TB 25

Goph. no/w 2 hrs prep to Acid

JUN 19 '57