


Section 2 Township 12 Range 17-W

Well No. #3 Hall "D"

Company Cities Service

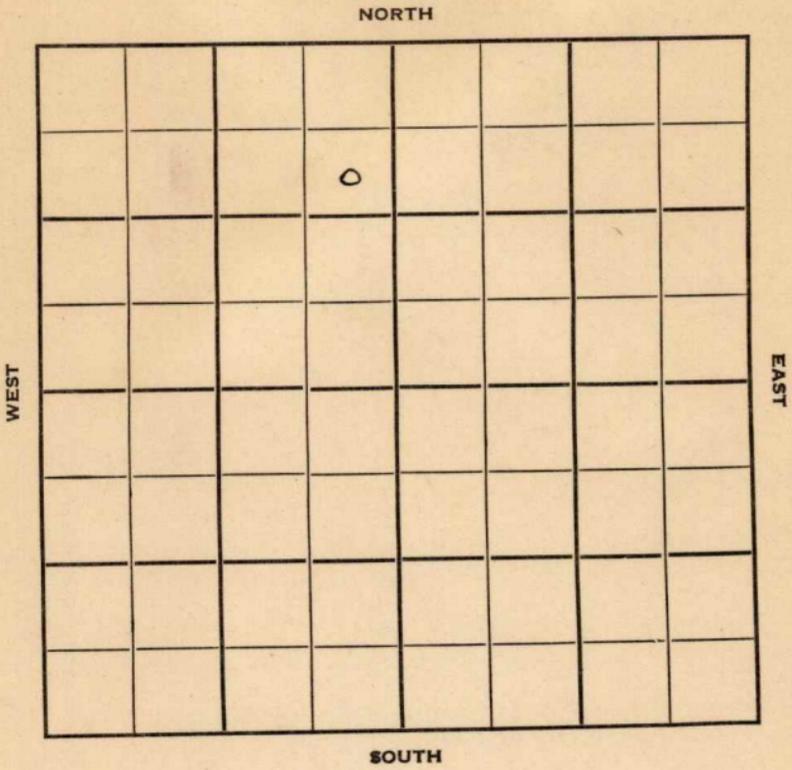

Ellis

Sec. 2 Twp. 12 R. 17W

Well No. #3 Hall "D" Farm

Cities Service Company

Contractor


990' Ft. from N. Line

_____ Ft. from S. Line

330' Ft. from E. Line

_____ Ft. from W. Line

SE NE NW

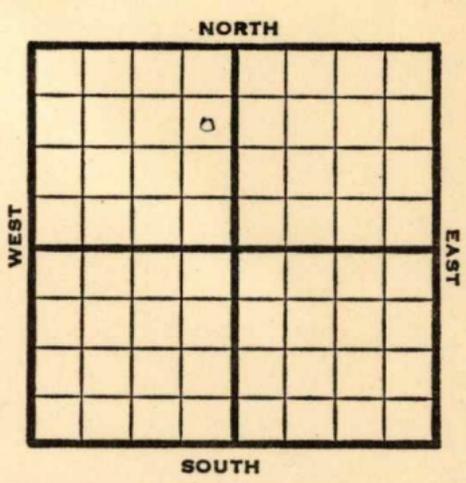

1950

Elev. 2113' REPORT

3/1

Location

5/24

8" @ 1318'
Heebner 3294'
Dodge 3318'
Lans. 3353'
Arb. 3597'
 TD 3660'
 5" @ 3660'
 23/3631-35
 30/3626-20
 Pump 14 bbl. fluid PD & 24% wtr
 7500 acid
 24/3619-23
 23/3615-17
 500 acid
 PB 3612'
 48/3596-3609
 33/3604-10
 1000 acid
 Comp. 69 BOPD, 7% wtr.

COMPLETED

Kansas

Map No. _____ Sec. 2 Twp. 12 R. 17W

Well No. 3 Hall "D"

Cities Service Company

Contractor

SE NE NW


SECTION PLAT

990 Ft. from N. Line

_____ Ft. from S. Line

330 Ft. from E. Line

_____ Ft. from W. Line

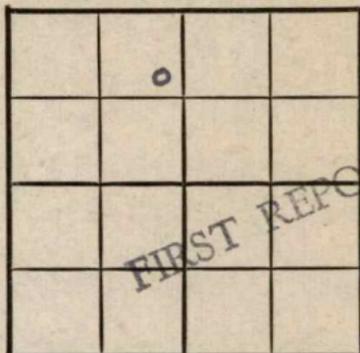

Ellis County

Location X

Rig up _____

Drilling and Remarks:

RECORD

Cased _____ in., _____ ft.

Sand _____

Gas _____

Oil _____

Total Depth _____

PRODUCTION

1st 24 hrs. Nat. _____

1st 24 hrs. after shot _____

Gas _____ Cu. Ft.

Dry Hole _____

Abandoned _____

Date

MAR 1 1950 19

J. E. TYRA

Scout

Kansas

Map No. _____ Sec. 2 Twp. 12 R. 17W

Well No. 3 Hall "D"

Cities Service Company

Contractor

SE NE NW

E1.2113
SECTION PLAT

990 Ft. from N. Line

_____ Ft. from S. Line

330 Ft. from E. Line

_____ Ft. from W. Line

	0		
COMPLETE			

Ellis

Location _____

Rig up _____

Drilling and Remarks:

8" c 1318
Hebner 3294
Lodge 3318
Lans. 3353
arb. 3597
T.D. 3660
5" c 3660

RECORD

Cased _____ in., _____ ft.

Sand _____

Gas _____

Oil _____

Total Depth _____

PRODUCTION

1st 24 hrs. Nat. _____

1st 24 hrs. after shot _____

Gas _____ Cu. Ft.

Dry Hole _____

Abandoned _____

Date

MAY 24 1950

19

J. E. TYRA

Scout

23/ 3631-35

30/ 3626-20

Pump 14 bbl. fluid pd +24% water
7500 acid

24/ 3619-23

23/ 3615-17

500 acid

PB 3612



48/ 3596-3607

33/ 3604-10

1000 acid

Comp. 69 bpd

JUN 5 1950
7% water

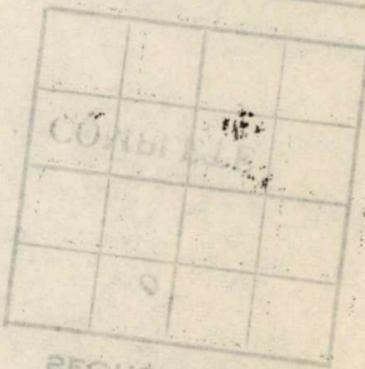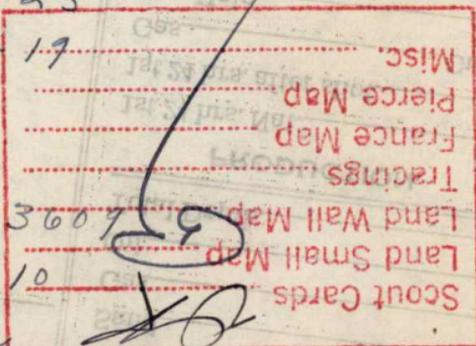

SECTION 17-11

Contractor

Company

Map No.

Map No.

Sec

5

Twp

13

R

11

Form 25 300 B&C 11-13 1949