


Section 26 Township 16 Range _____

Well No. #1 Dolecheck

Company Eldorado Refg.

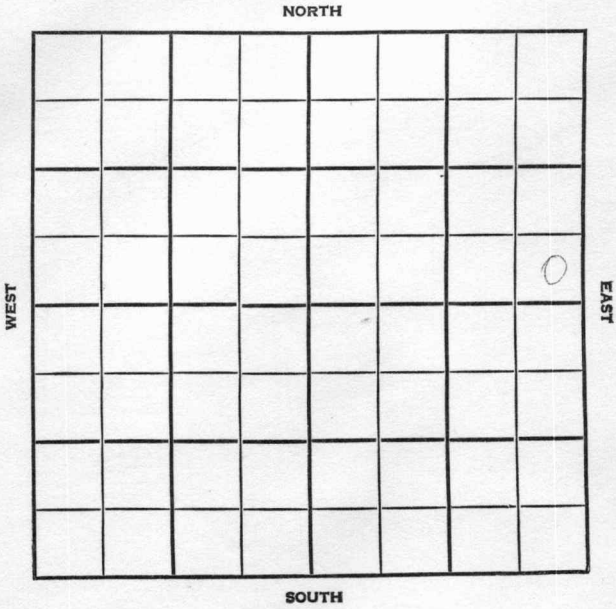

County Barton Elev. _____
 Sec. 26 Twp. 16 Rge. 12W
 Company ELDorado Refg.
 Farm Name Dolecheck No. 1

TOPS	DEPTH	LOG	DATUM
Anh.			
Tp.			
H.			
Tr.			
Dg.			
Bl.			
L.			
K.C.			
B.K.C.			
Ce.			
C.			
M.			
M.			
K.			
Mz.			
Mq.			
V.			
S.			
S.			
A.			
R.			
Pe.			
G.			
T.D.			

Loc. in Sec. SE SE NE
 Geol. _____
 Contr. Garvey Tools
 Pool Kraft-Prusa

FIRST REPORT
 NOV 17 1946

Date Comm. spd. 11-3-56
8" @ 312 w/200, Drlg. 1945

NOV 5 1956

H.C.

R.

County Barton Elev. 1933
 Sec. 26 Twp. 16 Rgs. 12W
 Company Eldorado Refg.
 Farm Name Dolecheck No. 1

TOPS	DEPTH	LOG	DATUM	Loc. in Sec.
Anh.				SE SE NE
Tp.	2728			
H.	2975			
Tr.				
Dg.	3005			
Bl.	3067			
L.	3081			
K.C.				Geol.
B.K.C.				Contr.
Ce.				Garvey Tools
C.				
M.				Pool
M.				Kraft-Prusa
K.				
Mz.				
Ma.				
V.				
S.				
S.				
A.				
R.	3318			
Pe.				
G. wh	3332			
T.D.	3375			



Date Comm. spd. 11-3-56
8" @ 312 w/200, Drlg. 1945 NOV 10 '56
DST 2913-19 ap 1hr 10' 50 GCM
+ 20' md BHP 1110/20" BHP 1110/20"
DST 3072-3101 30" rec 10' md
BHP 290/20" DST 3314-24 30"
5' md BHP 0

D&A