FORM 51 10M 2-49 PETROL

KANSAS


Ellis

Section 2 Township 12 Range 17W

Well No. 2 Hall "B"

Company Cities Service

Bemis

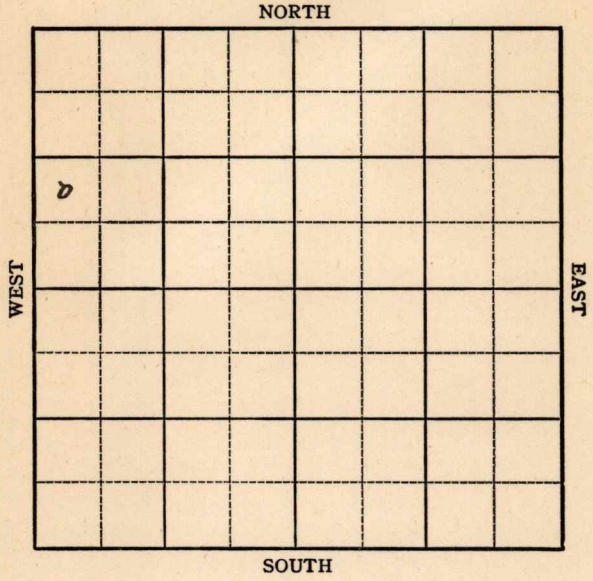

FORM 252-A
5M 10-48 PETROL

KANSAS

Ellis

Sec. 2 Twp. 12 R. 17W ✓

Well No. #2 Hall "B" Farm

Cities Service Company

Bemis Pool


_____ Ft. from N. Line

990' Ft. from S. Line

_____ Ft. from E. Line

330' Ft. from W. Line

NW SW NW

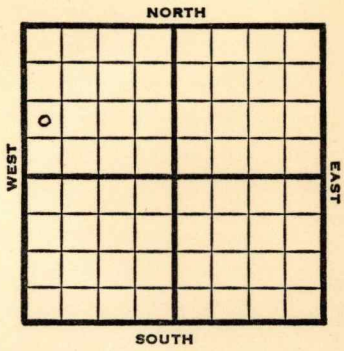

1949	Elev 2116' REPORT
4/6	Location
4/12	"
4/20	"
4/27	8"@ 1196'
	Drlg 1355'
5/4	Lansing 3344'
	Cong 3613'
	Drlg 3674'
5/11	TD 3720'
	Arb. 3688'
	Aband.

ABANDONED

Form 26 200 Bks. 9-48 Petrol

Bemis Pool

Kansas

Map No. _____ Sec. 2 Twp. 12 R. 17W


Well No. 2 Hall "B"

Cities Service Company

FIRST REPORT Contractor

NW SW NW

SECTION PLAT

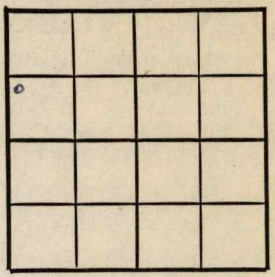

_____ Ft. from N. Line

990 Ft. from S. Line

_____ Ft. from E. Line

330 Ft. from W. Line

Ellis County

Location x

Rig up

Drilling and Remarks:

RECORD

Cased _____ in., _____ ft.

Sand

Gas

Oil

Total Depth

PRODUCTION

1st 24 hrs. Nat.

1st 24 hrs. after shot

Gas _____ Cu. Ft.

Dry Hole

Abandoned

Date

APR 6 1949 19 S. J. LEWIS Scout

Form 26 200 Bks. 9-48 Petrol

Bemis Pool

Kansas

Map No. K 71 Sec. 2 Twp. 12 R. 17W

Well No. 2 Hall "B"


Cities Service Company

ABANDONED Contractor

NW SW NW

E 12116

SECTION PLAT

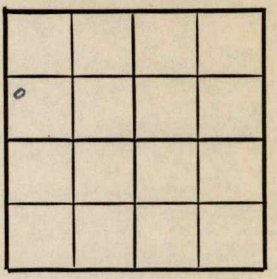

Ft. from N. Line

990 Ft. from S. Line

Ft. from E. Line

330 Ft. from W. Line

Ellis County

Location

Rig up

Drilling and Remarks:

RT # 3688

RECORD

Cased in., ft.

Sand

Gas

Oil

Total Depth 3220

PRODUCTION

1st 24 hrs. Nat.

1st 24 hrs. after shot

Gas Cu. Ft.

Dry Hole

Abandoned

Date

MAY 11 1949 19

S. J. LEWIS Scout