


Section 2 Township 12 Range 17W

Well No. #1 Hall (Q)

Company Cities Service Oil

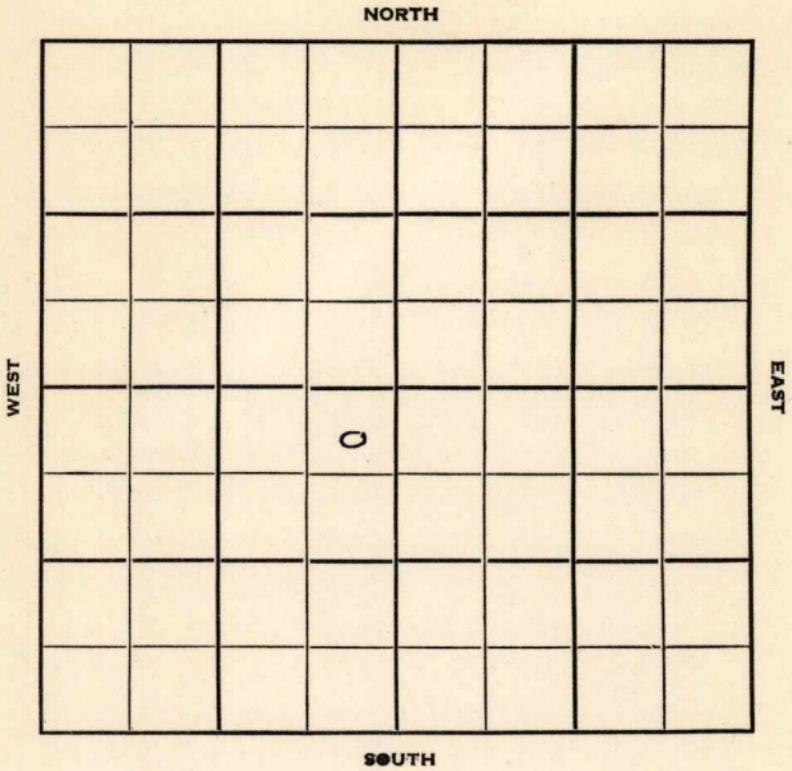

Sec. 2 Twp. 12 R. 17W ✓

Well No. #1 Hall (Q) Farm _____

Cities Service Oil Company _____

Contractor _____


330 Ft. from N. Line

_____ Ft. from S. Line

330 Ft. from E. Line

_____ Ft. from W. Line

NE NE SW

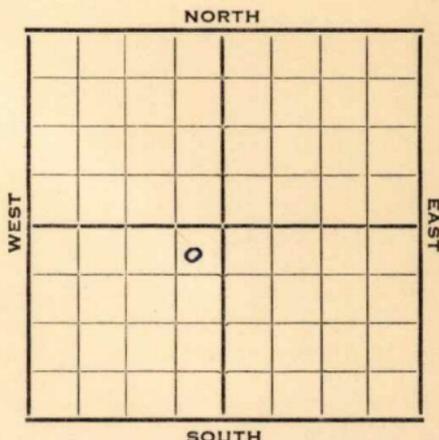

1952

Elev. 2118' REPORT

1/16

8" @ 237'

2/6

Heeb. 3304

Dodge 3328

Lans. 3353

Simp sh 3616

Arb. 3619

RTD 3627 5" @ 3621 3000 A

P 45 BO & 160 BW RP 3627 P 32

BO & 41 BW 7 hrs.

2/13

CO to 3632 P/4 BO & 80 BW 16 hrs.

2/20

No report

3/5

D&A TD 3638

8" @ 237'

Heeb. 3304

Dodge 3328

Lans. 3353

Simp 3616

Arb. 3619

TD 3627 5" @ 3621 DD 3638

1000 A P 21 bo 9½ bwpd 3000 A

P/45 bo 160 bw PB3627

P/32 bo 41 bw 7 hr. CO to 3632

P/4 bo 80 bw 16 hr. D&A

ABANDONED

County **Ellis** State **Kansas**

Sec. **2** (Blk. (Twp.)) **12** (Sur. (Rge.)) **17W** Map No.

Operator **Cities Service Oil**

Well No. **1** Farm **Hall (Q)**

Elev. Location **NE NE SW**



330 Ft. From **N** Line **SW**

330 Ft. From **E** Line Quarter

1st. Report **JAN 16 1952**

Completion

Remarks

Spudding Date

Drlg. Data

8" @ 237

J. E. TYRA

