

KANSAS

Russell

Section 15 Township 15 Range 13W

Well No. 1 Ely

Company El Dorado Ref.

NORTH **Trapp**

							0

WEST

EAST

SOUTH

Sec. 15 Twp. 15 R. 13W

Well No. #1 Ely Farm

El Dorado Ref. Company

Trapp (A B & W Drlg., Cont.)


Pool
330' Ft. from N. Line

Ft. from S. Line

330' Ft. from E. Line

Ft. from W. Line

NE/C

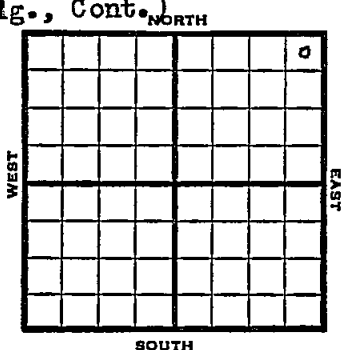

1949 Elev 1817' REPORT

- 7/6 Location
- 7/12 "
- 7/20 8" @ 257'
Drlg 1660'
- 7/27 Tarkio 2460'
Lansing 3018'
Drlg 3165'
- 8/3 Arbuckle 3291'
5" @ 3145'
TD 3314'
- 8/10 TD 3317'
Dodge 2946'
Plug 2980
12 shots 2948-52'
12 shots 2946-50
500 acid
700' oil 12 hrs.
1500 acid after setting 12 hrs.
Swb 15 bbls oil
- 8/17 "
- 8/24 TD 3317'
Lans 3080'
Arb. 3291'
5" @ 3145'
5" @ 3145'
Perf Lans
1500 acid
Pump 89 Oil Pot
39° Gr.
Comp

COMPLETED

Map No. _____ Sec. 15 Twp. 15 R. 13W

Well No. 1 Ely

Eldorado Ref. _____ Company

A B & W Drlg. _____ Contractor

NE/C

FIRST REPORT
SECTION PLAT

330 Ft. from N. Line

_____ Ft. from S. Line

330 Ft. from E. Line

_____ Ft. from W. Line

			o

Russell County

Location X

Rig up _____

Drilling and Remarks:

RECORD

Cased _____ in., _____ ft.

Sand _____

Gas _____

Oil _____

Total Depth _____

PRODUCTION

1st 24 hrs. Nat. _____

1st 24 hrs. after shot _____

Gas _____ Cu. Ft.

Dry Hole _____

Abandoned _____

Date

JUL 6 1949 19

S. J. LEWIS Scout 1

Map No. K73 Sec. 15 Twp. 15 R. 13W

Well No. 1 Ely

Eldorado Ref. _____ Company _____

COMPLETE

Contractor _____

NE/C

E41877
SECTION PLAT

			6

330 Ft. from N. Line

_____ Ft. from S. Line

330 Ft. from E. Line

_____ Ft. from W. Line

Russell County

RECORD

Location _____

Cased _____ in., _____ ft.

Rig up _____

Sand _____

Drilling and Remarks:

Gas _____

Lease 2080

Oil _____

Ac 73291

Total Depth 3217

5" C 2 1/2 + 5"

PRODUCTION

1st 24 hrs. Nat. _____

Prof. Lease

1st 24 hrs. after shot _____

1500 acres

Gas _____ Cu. Ft.

Prod 85 oil 1st

Dry Hole _____

Abandoned _____

Date

85 2/2

AUG 24 1949 19 _____

S. J. LEWIS Scout