


Section 26 Township 16 Range 12 WWell No. # 1 Dolochek (Dolechek)Company B & R Drlg.

NORTH

WEST

EAST

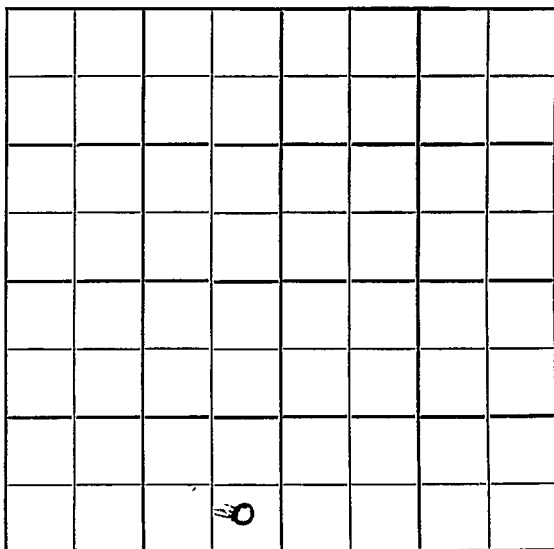

SOUTH



Sec. 26 Twp. 16 R. 12W

Well No. #1 Dolochek Farm

B & R Drlg. Company

B & R - Contr. Contractor

Semi-Wildcat

Ft. from N. Line

330'


Ft. from S. Line

330'

Ft. from E. Line

Ft. from W. Line

SE SE SW

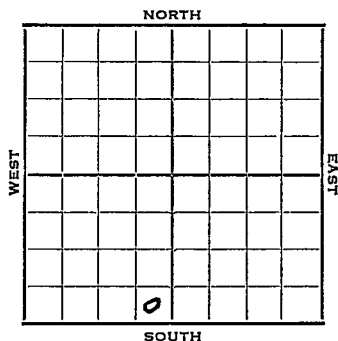

1952 Elev. 1919' REPORT

6/11 MIR
6/18 8" @ 307 Anhy 790 Drlg. 1892'
6/25 Heeb 3001' Br li 3090' KC 3112'
DST 3119-49, 1 hr, 30' M
Drlg. 3156'
7/2 Cong 3366 Arb. 3375 RTD 3377
5" @ 3376
7/9 WOCT
7/17 DD 3393 $\frac{1}{2}$ TD SO 500 A
S/10 BOPH for 6 hrs. POP
7/23 NR
7/30 NR
8/6 "
8/13 "
8/20 "
8/27 Spud 6-11-52
Oil Well TD 3393'
8" @ 307' Anhy 790' Heeb. 3001
Br Li 3090 KC 3112
DST 3119-49 open 1 hr. rec. 30' mud
O# Cong. 3366 Arb. 3375
TD 3377 5" @ 3376 DD 3393
500 A S/10 boph Comp. 50 bopd

COMPLETED

County Barton State Kansas

Sec. 26 (Blk. 16 (Sur. 12W Map No.

Operator B & R D-1E

Well No. 1 Farm Holscher

Elev. _____ Location SE SE SW

FIRST REPORT

330 Ft. From S Line SW
330 Ft. From E Line Quarter

1st. Report **JUN 11 1952**

Completion 7

Remarks Mid-State -FO

B & R Contr.

Spudding Date

Drlg. Data Semi Wildcat


J. G. McGEHEE

J. G. McGEHEE