

Section 26 Township 16 Range 12W

Well No. #1 Dolechek

Company Harms & Knight

NORTH

					0		

WEST

EAST

SOUTH

Barton

Sec. 26 Twp. 16 R. 12W

Well No. #1 Dolechek Farm

Harms & Knight Company

Contractor

Kraft-Prusa Pool


330' Ft. from N. Line

_____ Ft. from S. Line

_____ Ft. from E. Line

990' Ft. from W. Line

NE NW NE

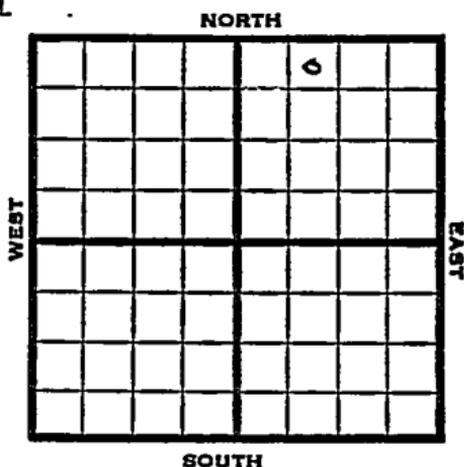

1951 Elev. 1932' REPORT

3/21 Spud 3-15-51
8" @ 222'
Anhy 793
Drlg. 2550'

3/28 Spud 3-15-51
D & A TD 3414'
8" @ 222 Anny 793' Top. 2686'
Heeb. 2992' Toronto 3009'
Douglas sh 3018', Doug sand 3035',
Br. lime 3082', Lans 3099',
Cong. 3343', Gr. wash 3351'
TD 3414' D & A

ABANDONED


County Barton State Kansas

Sec. 26 (Blk. 16 (Sur. 12W (Twp.) (Rge.) Map No.

Operator Harms & Knight

Well No. 1 Farm Dolechek

Elev. 1932 Location NE NW NE

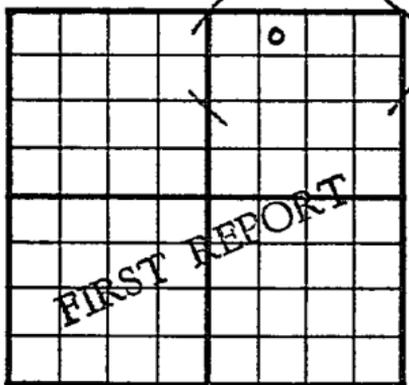

330 Ft. From N Line NE

990 Ft. From W Line Quarter

Ist. Report MAR 21 1951

Completion

Remarks

Spudding Date 3-15-51

Drlg. Data Kraft-Prusa Pool

8" @ 222 Anhy 793 drlg. 2550

J. E. TYRA

