


KANSAS

Section 26 Township 16 Range 12W

Well No. #1 Harzman

Company Sohio

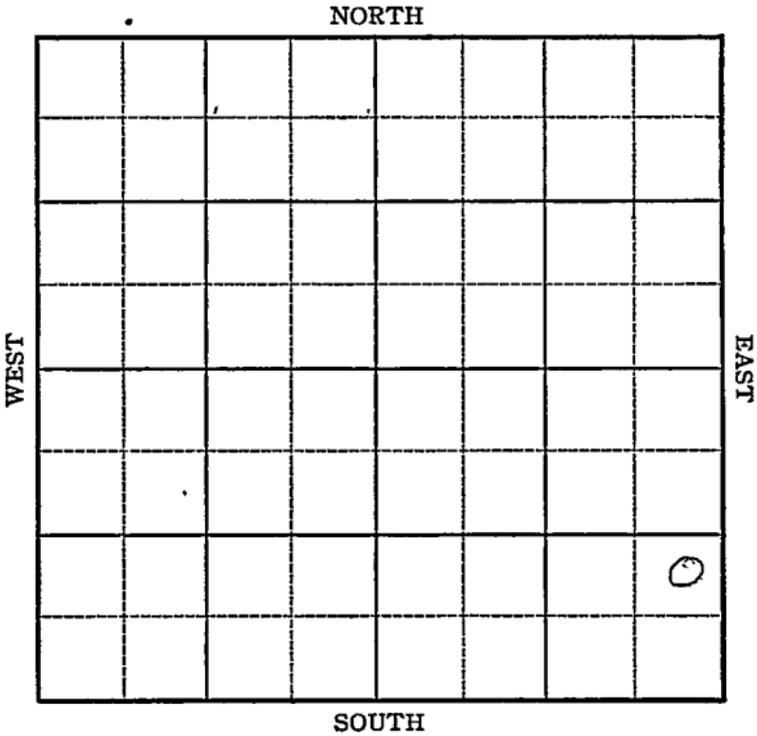

Barton


KANSAS

Sec. 26 Twp. 16 R. 12W

Well No. #1 Harzman Farm

Sohio Company

NORTH

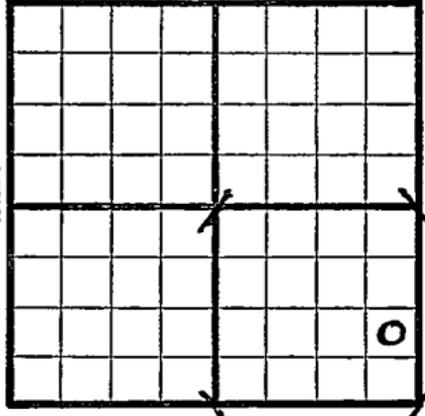

_____ Ft. from N. Line

990 Ft. from S. Line

330 Ft. from E. Line

_____ Ft. from W. Line

4les. 1938

1944 REPORT

4/26 Derrick

5/3 "

5/10 8" @ 522 WDCc

5/17 Drilling 2710

5/31 Cong 3392
 Arb 3442
 T D 3483

ABANDONED

