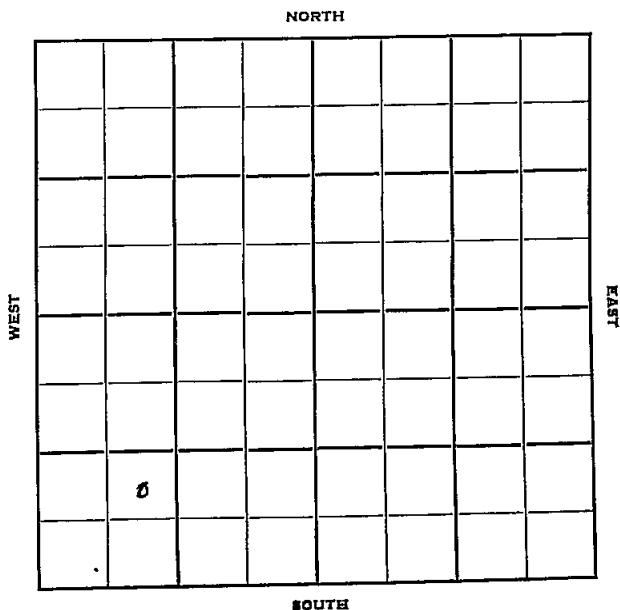


Section 14 Township 15 Range 13-WWell No. #1 SellensCompany E H Adair

Russell

KANSAS

Sec. 14 Twp. 15 R. 13W ✓

Well No. #1 ~~#2~~ Sellens Farm

E. H. Adair Company

Contractor


990' Ft. from N. Line

330' Ft. from S. Line

 Ft. from E. Line

990' Ft. from W. Line

NE
SE SW SW

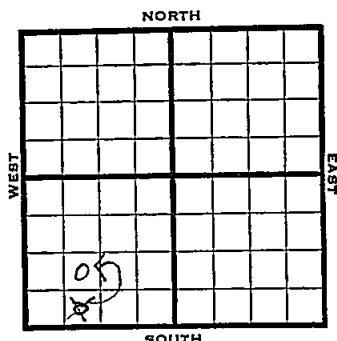

1950 Elev 1831' REPORT

2/15 RUR

4/19 TD 3306'
8" @ 278'
Tonki 2430'
Howard 2630'
Topeka 2705'
how oil 2889-92'
Heeb ner 2935'
Dodge 2952'
Show oil 2957-59
Br L 3014'
Lans 3025'
DST 3091-3104
Rec 270' oil
Cong 3292'
Arb. 3304'
5" @ 3305
TD 3306
24/3200-09 SS0
Set plug 3140
23/3090-98
1200' oil over nite
3000 acid
P_{mp} 12 BOPH 4 hrs.
P_ump 15 BOPH
Comp 376 BOPD
Comp

COMPLETED

K 205323

Map No. _____ Sec. 14 Twp. 15 R. 13WWell No. 1 SellensE. H. Adair

Company

CORRECTION

Contractor

NE SW SW

SECTION PLAT

o			

_____ Ft. from N. Line

990 Ft. from S. Line

_____ Ft. from E. Line

990 Ft. from W. LineRussell CountyStanolind farmout

Location _____

Rig up _____

Drilling and Remarks:

Reported

#2 Sellens

SE SW SW

RECORD

Cased _____ in., _____ ft.

Sand _____

Gas _____

Oil _____

Total Depth _____

PRODUCTION

1st 24 hrs. Nat. _____

1st 24 hrs. after shot _____

Gas _____ Cu. Ft.

Dry Hole _____

Abandoned _____

Date

FEB 16 1950₁₉J. E. TYRA

Scout

Map No. _____ Sec. 14 Twp. 15 R. 13WWell No. 2 SellensE. H. Adair

Company

Contractor

SE SW SW

SECTION PLAT


_____ Ft. from N. Line

330 Ft. from S. Line

_____ Ft. from E. Line

990 Ft. from W. Line

Russell County

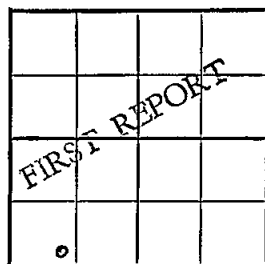

Location _____

Rig up _____

Drilling and Remarks:

R U R

RECORD

Cased _____ in., _____ ft.

Sand _____

Gas _____

Oil _____

Total Depth _____

PRODUCTION

1st 24 hrs. Nat. _____

1st 24 hrs. after shot _____

Gas _____ Cu. Ft.

Dry Hole _____

Abandoned _____


Date

FEB 15 1950

19

J. E. TYRA Scout

Kansas

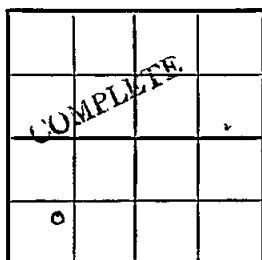Map No. _____ Sec. 14 Twp. 15 R. 13WWell No. 1 Sellens_____E. H. Adair_____
Company_____NE SW SW_____
ContractorEI. 1831
SECTION PLAT_____Ft. from N. Line_____990_____
Ft. from S. Line_____Ft. from E. Line_____990_____
Ft. from W. Line

Russell County

Location _____

Rig up _____

Drilling and Remarks:

8" @ 278
Jankis 2430
Harwood 2630
Topeka 2705
shaw oil 2889-92
Huebner 2935
Dodge 2952

Date

RECORD
Cased _____ in., _____ ft.

Sand _____

Gas _____

Oil _____

Total Depth 3306

PRODUCTION

1st 24 hrs. Nat. _____

1st 24 hrs. after shot _____

Gas _____ Cu. Ft.

Dry Hole _____

Abandoned _____

(over)

ccm

APR 19 1950 19

J. E. TYRA

Scout

shawail 2957-59

Br. L 3014

hars 3025

D.S.T. 3091-3104

Rec. 270 oil

Long. 3292

arb. 3304

5" @ 3305

T.D. 3306

24/3200-09 sso

Set plug 3140

23/3090-98

1200' oil over nite

3000 acid

Pump 12 bath 4 hrs.

Pump 15 bath

Scout Cards

Cond Small Map

Land Wall Map

Tracings

France Map

Pierce Map

Misc.

MAY 2

1959