

O.W.W.O.

FORM 51 25M 3-49 PETROL

KANSAS

Barton

Section 27 Township 16 Range 12^W


Well No. #1 McLaughlin

Company Honnaker Drlg.

NORTH

WEST

EAST

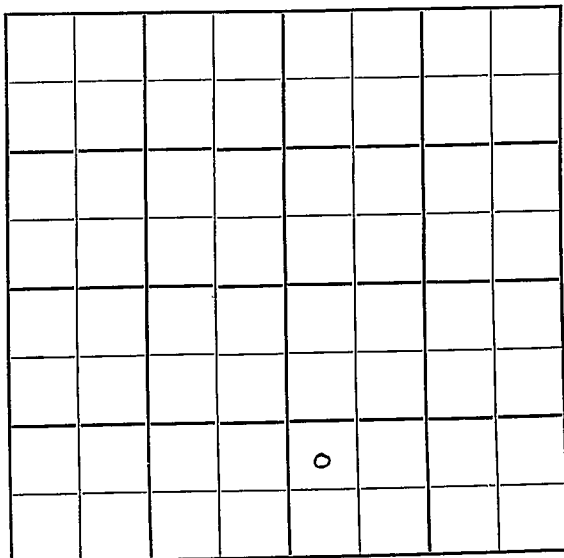

SOUTH

Barton

KANSAS

Sec. 27 Twp. 16 R. 12W

Well No. #1 McLaughlin Farm

Honnaker Drlg. Company

Honnaker Drlg. Contr. Contractor

Beaver, South

WVC
NORTH

Ft. from N. Line

990'


Ft. from S. Line

Ft. from E. Line

330'

Ft. from W. Line

NW SW SE

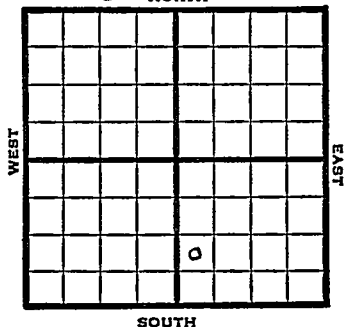

1950

Elev 1902

REPORT

6/14

Spud 6-11-50
8" @ 260'

WOC

9/20

8" @ 260

KC 3093

Cong 3348

Arb 3362-65

5" @ 3363

TD 3381

500 A S/1 1/2 boph Comp 25 bopd
Completed

COMPLETED

O.W.W.O.

1950

11/8

OTD 3381' Was Arb. well

SP 3292 24/3166-70 500 A

20/3166-70

S/12 BWPH SP 3150 48/3108-21

500 A

11/29

D&A TD 3381

OTD 3381 SP 3292

24/3166-70 500 A

20/3166-70 S/12 bwph SP 3150

48/3108-21 500 A D&A

ABANDONED

Kansas

Beaver, South

Map No. _____ Sec. 27 Twp. 16 R. 12WWell No. 1 McLaughlin

_____ Honnaker Drlg. _____ Company

_____ Contractor

NW SW SE

SECTION PLAT

FIRST REPORT

0

_____ Ft. from N. Line

990 Ft. from S. Line

_____ Ft. from E. Line

330 Ft. from W. Line

Barton County

Location _____

Rig up _____

Drilling and Remarks:

Spud 6-11-50

8" C 260

WOC

RECORD

Cased _____ in., _____ ft.

Sand _____

Gas _____

Oil _____

Total Depth _____

PRODUCTION

1st 24 hrs. Nat. _____

1st 24 hrs. after shot _____

Gas _____ Cu. Ft.


Dry Hole _____

Abandoned _____

Date

JUN 14 1950 19J. E. TYRA Scout

County Barton State Kansas
 Sec. 27 (Blk.) 16 (Sur.) 12W Map No.
 Operator Honaker Drlg.
 Well No. 1 Farm McLaughlin
 Elev. 1902 Location NW SW SE

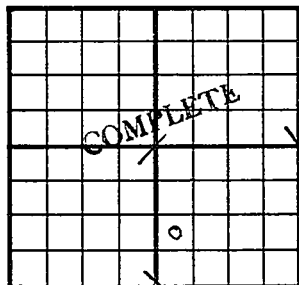

990 Ft. From S Line SE
330 Ft. From W Line Quarter

1st. Report ~~SEP 20 1950~~

Completion SEP 20 1950

Remarks

South Beaver Pool

Spudding Date 6-11-50

Drlg. Data Oil well TD 3381


8" @ 260 KC 3093 Cong. 3348

Arb. 3362-65 5 $\frac{1}{2}$ " @ 3363 TD 3381

500 A S/ 1 $\frac{1}{2}$ boph Comp. 25 bopd

J. E. TYRA

County Barton State Kansas
 Sec. 27 (Blk.) 16 (Sur.) 12W Map No.
 Operator Honaker Drlg. (was C. E. Ash)
 Well No. 1 Farm McLaughlin
 Elev. Location NW SW SE

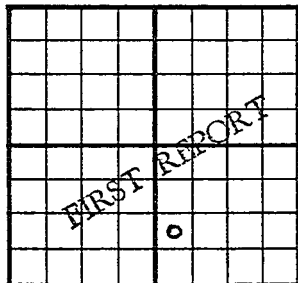

990 Ft. From S Line SE
330 Ft. From W Line Quarter
 Ist. Report NOV 8 1950
 Completion O.W.W.O.
 Remarks (OWWO)
Honaker Drlg. - Contr.
 Spudding Date

Drlg. Data Beaver Pool

OTD 3381 Was Arb. well

SP 3292 24/ 3166-70 500 A 20/ 3166-70

S/ 12 bwph SP 3150 48/ 3108-21 500 A

J. E. TYRA

County Barton State Kansas

Sec. 27 (Blk.) 16 (Sur.) 12W Map No.

Operator Honaker Drlf.

Well No. 1 Farm McLaughlin

Elev.	Location	NW	SW	SE
-------	----------	----	----	----

ABANDONED

0

990 Ft. From S Line SE

330 Ft. From W Line Quarter

1st. Report

Completion NOV 29 1950

Remarks OWWO

Honaker Drlg. - Contr.

Spudding Date _____

Drig. Data D & A TD 3381 Beaver Pool

OTD 3381 SP 3292 24/ 3166-70

500 A 20/ 3166-70 S/ 12 bwph SP 3150

48/ 3108-21 500 A D & A

E. TYRA