


Section 14 Township 15 Range 13W

Well No. #2 M. Kejr "B"

Company Shell

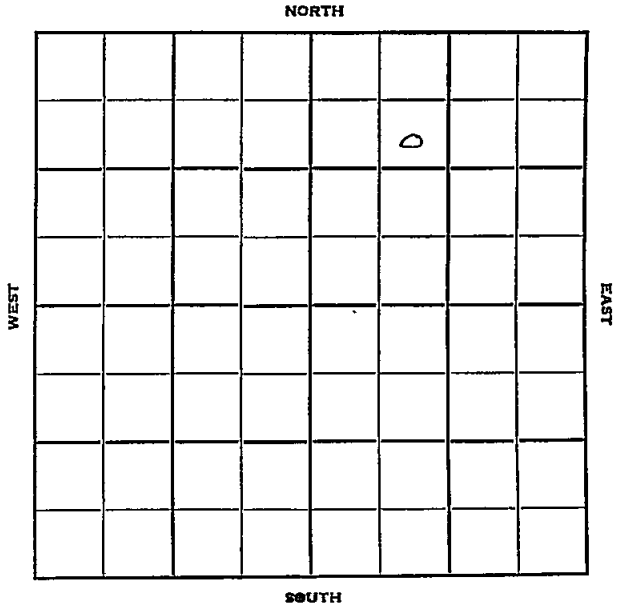

Russell KANSAS

Sec. 14 Twp. 15 R. 13 W

Well No. # 2 M. Kejr "B" Farm

Shell Company

Contractor

Ely Pool


990 Ft. from N. Line

 Ft. from S. Line

 Ft. from E. Line

992 Ft. from W. Line

SE NW NE

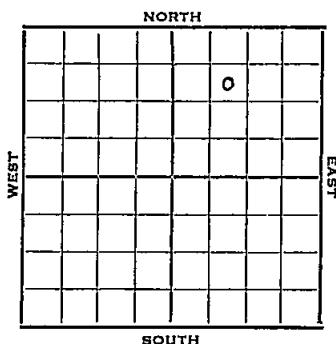

1951

Elev. 1790' REPORT

12/5

Location

1952

1/16

Spud 12-5-51

Oil Well TD 3267'

10" @ 755 Anhy 748 Top. 2647

Tor. 2895 Lans. 2972 Arb. 3253

TD 3267 7" @ 3266 76/ 2993-3012

3000 A P/ 207 BO 15 BW 15 hr.

Comp. 262 BOPD

COMPLETED

County Russell State KansasSec. 14 (Blk. Twp.) 15 (Sur. Rge.) 13W Map No.Operator ShellWell No. 2 Farm M. Keir "B"Elev. Location SE NW NE

				0			

FIRST REPORT

990 Ft. From N Line NE992 Ft. From W Line Quarter1st. Report DEC 5 1951

Completion

Remarks

Spudding Date

Drlg. Data Ely Pool


Location

County Russell State Kansas
 Sec. 14 (Blk. Twp.) 15 (Sur. Rge.) 13W Map No.

Operator Shell

Well No. 2 Farm M. Kejr "B"

Elev. 1790 Location SE NW NE

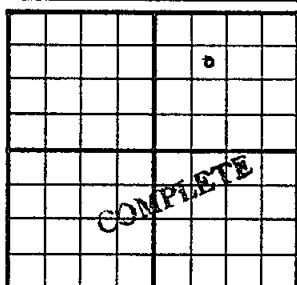

990 Ft. From N Line NE

992 Ft. From W Line Quarter

1st. Report

Completion JAN 16 1952

Remarks Ely Pool

K & E Drlg. - Contr.

Spudding Date 12-5-51

Drlg. Data Oil well TD 3267

10" @ 755 Anhy 748 Top. 2647

Tor. 2895 Lans. 2972 Arb. 3253

TD 3267 7" @ 3266 76/ 2993-3012

3000 A P/ 207 bo 15 bw 15 hr.

Comp. 262 bopd

J. E. TYRA