


Section 26 Township 16 Range 12W

Well No. #1 Harzman

Company Vickers Pet.

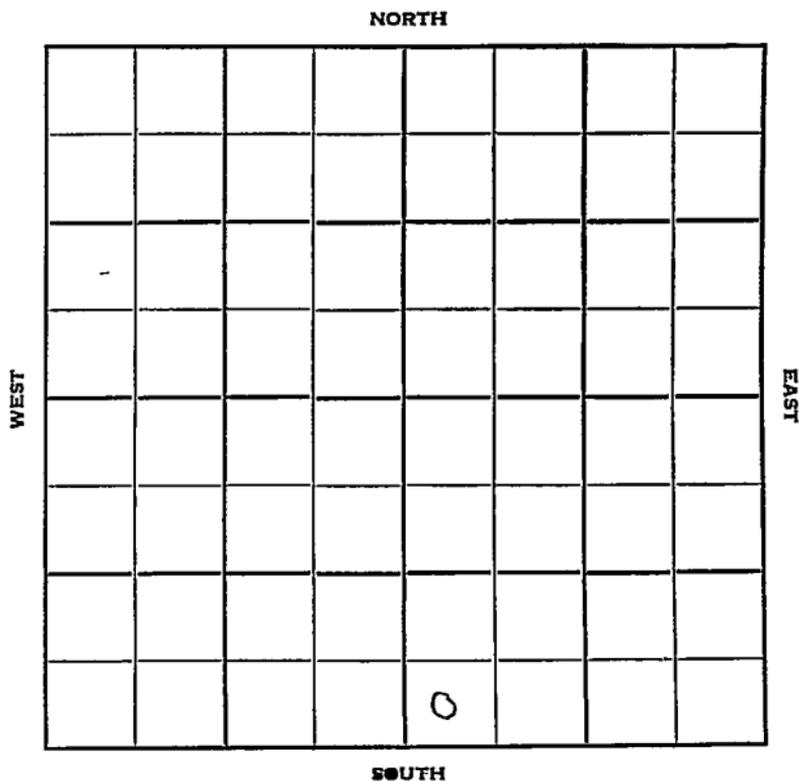

Sec. 26 Twp. 16 R. 12 W

Well No. # 1 Harzman Farm

Vickers Pet. Company

Jayhawk Drlg. Contractor

Ft. from N. Line

330


Ft. from S. Line

Ft. from E. Line

330

Ft. from W. Line

SW SW SE

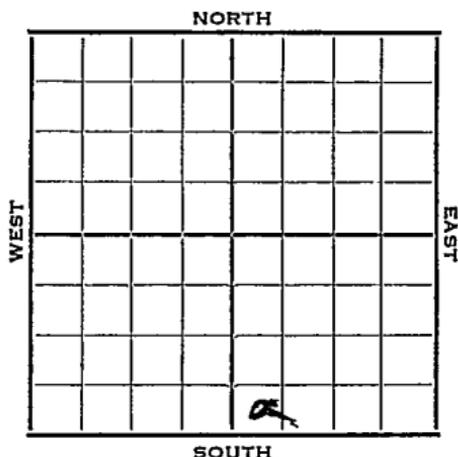

1952

Elev. 1934' REPORT

7/23

Spud 7-17-52
8" @ 317'
Drlg. 2030'

7/30

Spud 7-17-52
D & A TD 3436' 8" @ 317
Heeb 3020' Tor. 3035' Doug. 3050'
Br. lime 3116' Lans. 3135'
DST 3135-56 open 3/4 hr. rec 10' VSOCM
Arb. 3408'
DST 3408-24 open 1/2 hr. rec 18' mud
DST 3424-36 open 1/2 hr. rec 600' SW
D & A

ABANDONED.

