

Section 26 Township 16 Range 12WWell No. #1 IanatschCompany Honaker Drlg.

NORTH

WEST

EAST

1							
0							

SOUTH

Barton

KANSAS

Sec. 26 Twp. 16 R. 12W

Well No. #1 Lanatsch Farm

Honaker Drlg. Company

Honaker Drlg. Contractor

Wildcat

 Ft. from N. Line


330 Ft. from S. Line

 Ft. from E. Line

330

 Ft. from W. Line

SW SW SW

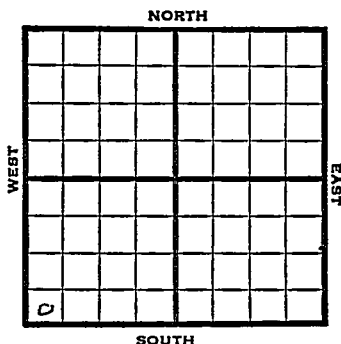

1951

Elev. 1899 REPORT

12/5

Spud 11-29-51
8" @ 268' Anhy 785
Drlg. 1980'

1952
2/6

TD 3370
5" @ 3359' POP

2/13
2/20

No report
"

3/5

"

3/11

"

1952
3/19

Spud 11-29-51
Oil Well TD 3370
8" @ 268 Anhy 785
Heeb. 2985 Br Lime 3081
KC 3101 Arb. 3354-70
DST 3359-70 opn 1½ hr. Rec. 336'
oil 5" @ 3359 CO to 3370
S/2¼ boph 500 A S/12 boph
Comp. 50 bopd

COMPLETED

County **Barton** State **Kansas**
 Sec. **26** (Blk. Twp.) **16** (Sur. Rge.) **12W** Map No.
 Operator **Honaker Drlg.**
 Well No. **1** Farm **Lanatsch**
 Elev. Location **SW SW SW**

0							

FIRST REPORT

330 Ft. From **S** Line **SW**
330 Ft. From **W** Line Quarter
 1st. Report **DEC 5 1951**
 Completion
 Remarks
Honaker Drlg. - Contr.
 Spudding Date **11-29-51**

Drlg. Data **Wildcat**

8" @ 268 Anhy 785 drlg. 1980

J. E. TYRA

County Barton State Kansas
 Sec. 26 (Blk.) 16 (Sur.) 12W Map No.

Operator Honaker Drlg.

Well No. 1 Farm Lanatsch

Elev. 1899 Location SW SW SW

0							

330 Ft. From S Line SW

330 Ft. From W Line Quarter

1st. Report

Completion MAR 19 1952

Remarks Wildcat

Honaker Drlg. - Contr.

Spudding Date 11-29-51

Drlg. Data Oil well TD 3370

8" @ 268 Anhy 785 Heeb. 2985

Br. lime 3081 KC 3101 Arb. 3354-70

DST 3359-70 open $1\frac{1}{2}$ Hr. Rec. 336' oil

5" @ 3359 CO to 3370 S/ $2\frac{1}{4}$ boph

500 A $\frac{3}{4}$ " 12 boph Comp. 50 bopd

J. G. McGEHEE